

**OREGON CORNER RESTORATION FORM**

Section 30  
County Umatilla

Township 3N  
Date: 09/15/09

Range 29E

Corner Designation: 3N29V1

Corner common to sections 30,31, T3NR29E, and 25, 36, T3NR28E.

_____	Condition Report Only
<input checked="" type="checkbox"/>	Not Found
<input checked="" type="checkbox"/>	Remonumented
_____	Unrecorded
<input checked="" type="checkbox"/>	Surveyed In
<input checked="" type="checkbox"/>	Referenced Out

**Previous Renewals / Surveys, etc.**


Originally Surveyed by Gates in 1859. He set a post in a mound of earth.

Wayne Harris set a 1/2" iron rebar and a stone at this position in Survey Q-1655 done in 1964, but there has been so much grader work on the roads in this area I could not find it.

**Monuments and Accessories Found: (Condition and Source)**

None.


**Diagram**

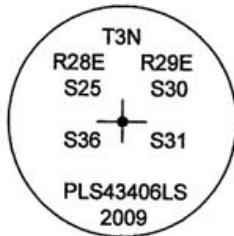

MP 3 Sign

No Trespass Sign

**Sketch**

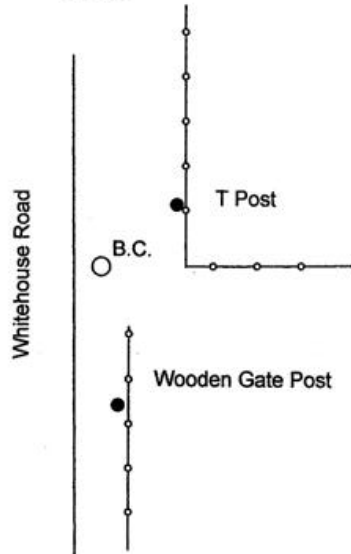

NAD 83/91  
OREGON STATE PLANE NORTH  
INTERNATIONAL FEET

N745226.69  
E8521836.55

LAT - 45° 42' 14.21666" N  
LON - 119° 14' 54.38509" W

**Monument (s) Set (Procedures and Description)**

Set a 1 1/4" x 30" galvanized iron pipe with a 2 1/2" brass cap at projection of old fenceline and using the monuments to the North and South for line.

**References Set:**

- A 1/2" Iron rebar w/ypc #43406 at steel fence post, lies N 44°00' E, 34.40'.
- A 1/2" Iron rebar w/ypc #43406 at wooden gate post, lies S 9°15' E, 57.80'.
- A 1/2" Iron rebar w/ypc #43406 on a no trespass sign, lies S 33°15' W, 141.86'.
- A 1/2" Iron rebar w/ypc #43406 at mile post 3 sign, lies N 15° W, 116.57'.

**Location and Comments**

From the intersection of Hwy. 320 and Whitehouse Road, go 1.5 miles South.

**Compass Declination**

17° E

**Surveyors Seal**

REGISTERED  
PROFESSIONAL  
LAND SURVEYOR

*Robert D. English*  
OREGON  
JANUARY 11, 2005  
ROBERT DOUGLAS ENGLISH  
43406LS

RENEWAL DATE: 12/31/09

RECEIVED BY:

Firm / Agency

Date: 1-11  
Rec'd By: KK  
No. 11-19-R

Survey One, LLC.  
P.O. Box 382  
Pendleton, OR 97801  
(541) 276-2055