

OREGON CORNER RESTORATION FORM

Section 29,32 Township 3N
County Umatilla Date: 03/08/10

Range 29E

Corner Designation: 3N29V7

1/4 Corner common to sections 29,32 T3NR29E



- _____ Condition Report Only
- _____ Not Found
- _____ Remonumented
- _____ Unrecorded
- _____ Surveyed In
- _____ Referenced Out

Previous Renewals / Surveys, etc.

Originally Surveyed by Gates, set a post in a mound of earth, 1859.
Harris set 1/2" Iron Pin and stone in Survey No. Q-1655.

Monuments and Accessories Found: (Condition and Source)

None.

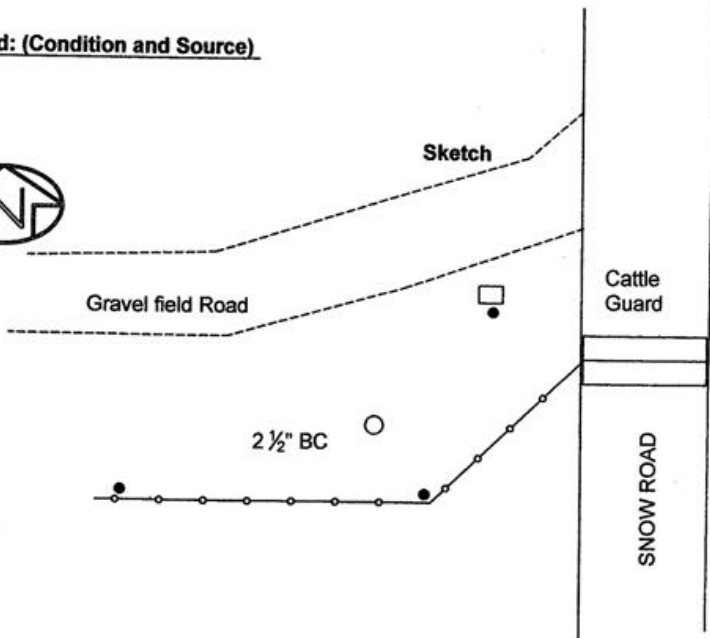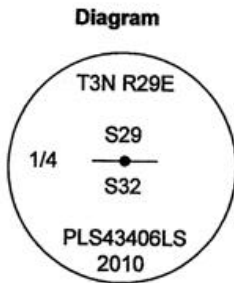

NAD 83/91
OREGON STATE PLANE NORTH
INTERNATIONAL FEET

N745451.71
E8530365.38

LAT - 45° 42' 15.11625" N
LON - 119° 12' 54.16949" W

Monument (s) Set (Procedures and Description)

Set a 1 1/4" x 30" galvanized iron pipe with a 2 1/2" brass cap, stamped as shown above. The monument is flush with the ground.
Corner set by single proportionate method from found monuments East and West. Old plow berm East confirms Northing location.

References Set:

- A 5/8"x30" Iron rebar w/ypc #43406 lies N 81°45' E, 71.12'.
- A 5/8"x30" Iron rebar w/ypc #43406 lies N 59° E, 23.95'.
- A 5/8"x30" Iron rebar w/ypc #43406 lies S 44°45' E, 22.42'.
- A 5/8"x30" Iron rebar w/ypc #43406 lies S 67°30' W, 41.82'.

Location and Comments

The corner is 2.2 miles South of the intersection of Hwy. 320 and Snow Road.

Compass Declination
17° E

Surveyors Seal

REGISTERED
PROFESSIONAL
LAND SURVEYOR

Robert D. English
OREGON
JANUARY 11, 2005
ROBERT DOUGLAS ENGLISH
43406LS

RENEWAL DATE: 12/31/11

RECEIVED BY:

Date: 1-11
Rec'd By: KK
No. 11-19-R

Firm / Agency

Survey One, LLC.
P.O. Box 382
Pendleton, OR 97801
(541) 276-2055