

**OREGON CORNER RESTORATION FORM**

Section 31,32

Township 3N

Range 29E

County Umatilla

Date: 04/26/10

Corner Designation: 3N29X5

Corner common to sections 31,32 T3NR29E.

_____	Condition Report Only
<u>  X  </u>	Not Found
<u>  X  </u>	Remonumented
_____	Unrecorded
<u>  X  </u>	Surveyed In
<u>  X  </u>	Referenced Out


**Previous Renewals / Surveys, etc.**

Originally Surveyed by Gates. He set a post in a mound of earth in 1859. Harris set a stone and a 1/2" Iron rebar in survey #Q-1655


**Monuments and Accessories Found: (Condition and Source)**

None.

**Diagram**

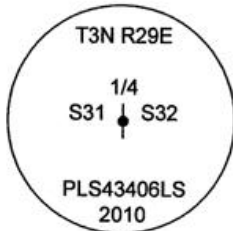

**Sketch**

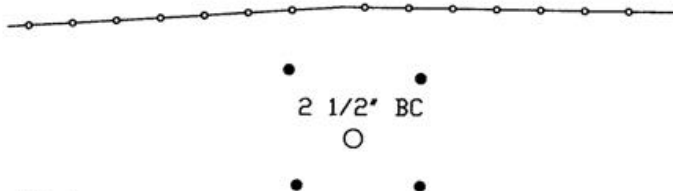

NAD 83/91  
OREGON STATE PLANE NORTH  
INTERNATIONAL FEET

N742689.17  
E8527737.19  
LAT - 45° 41' 48.25109" N  
LON - 119° 13' 31.806304" W

**Monument (s) Set (Procedures and Description)**

A 1 1/2" x 30" Galvanized iron pipe w/ a 2 1/2" Brass capped monument 19" below surface, stamped as shown above.

**References Set:**

- A Pink magnet 14" deep lies S 47°20' E, 16.43'.
- A Blue magnet 14" deep lies S 44°00' W, 18.74'.
- An Orange magnet 14" deep lies N 0°30' W, 23.02'.
- A Silver magnet 14" deep lies N 45°30' E, 17.32'.

**Location and Comments**

The corner is 2.75 miles South from the intersection of HWY. 320 and Snow Road, and West 0.5 miles along a fence.

**Compass Declination**

17° E

**Surveyors Seal**

REGISTERED  
PROFESSIONAL  
LAND SURVEYOR

*Robert D. English*  
OREGON  
JANUARY 11, 2005  
ROBERT DOUGLAS ENGLISH  
43406LS

RENEWAL DATE: 12/31/11

**RECEIVED BY:**

Date: 5-10  
Rec'd By: RC  
No. 10-86-R  
10-86-R

**Firm / Agency**

Survey One, LLC.  
P.O. Box 382  
Pendleton, OR 97801  
(541) 276-2055