

OREGON CORNER RESTORATION FORM

Section 31,32 Township 3N
County Umatilla Date: 04/26/10

Range 29E

Corner Designation: 3N29X5

Corner common to sections 31,32 T3NR29E.

- Condition Report Only
- Not Found
- Remonumented
- Unrecorded
- Surveyed In
- Referenced Out


Previous Renewals / Surveys, etc.

Originally Surveyed by Gates. He set a post in a mound of earth in 1859.
Harris set a stone and a 1/2" Iron rebar in survey #Q-1655


Monuments and Accessories Found: (Condition and Source)

None.

Diagram

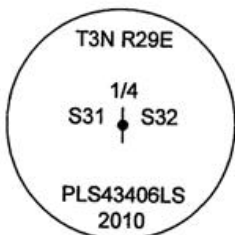

Sketch

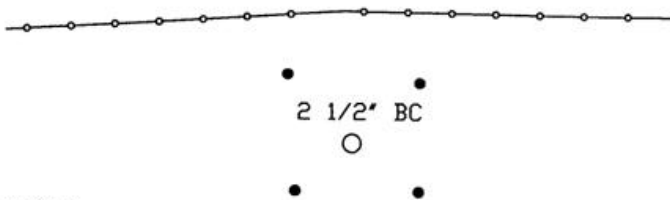

NAD 83/91
OREGON STATE PLANE NORTH
INTERNATIONAL FEET

N742684.35
E8527742.51
LAT - 45° 41' 48.20742" N
LON - 119° 13' 31.73920" W

Monument (s) Set (Procedures and Description)

A 1 1/2" x 30" galvanized iron pipe w/ a 2 1/2" brass capped, 19" below surface, stamped as shown above.

References Set: "Deep One" magnets by Berntsen.

- A Pink magnet 14" deep lies S 47°20' E, 16.43'.
- A Blue magnet 14" deep lies S 44°00' W, 18.74'.
- An Orange magnet 14" deep lies N 0°30' W, 23.02'.
- A Silver magnet 14" deep lies N 45°30' E, 17.32'.

Location and Comments

The corner is 2.75 miles South from the intersection of HWY. 320 and Snow Road, and West 0.5 miles along a fence.

Compass Declination
17° E

Surveyors Seal

REGISTERED
PROFESSIONAL
LAND SURVEYOR

Robert D. English
OREGON
JANUARY II, 2005
ROBERT DOUGLAS ENGLISH
43406LS

RENEWAL DATE: 12/31/II

RECEIVED BY:

Date: 1-11
Rec'd By: KE
No. 11-20-R

Firm / Agency

Survey One, LLC.
P.O. Box 382
Pendleton, OR 97801
(541) 276-2055