

OREGON CORNER RESTORATION FORM

Section 33,34

Township 3N

Range 29E

County Umatilla

Date: 01/15/10

Corner Designation: 3N29Z13

Corner common to sections 33,34 T3NR29E, 3,4, T3NR28E.

- Condition Report Only
- Not Found
- Remonumented
- Unrecorded
- Surveyed In
- Referenced Out

Previous Renewals / Surveys, etc.

Originally Surveyed by David P. Thompson. He set a post in a mound of earth in 1859. Harris set a 3" Iron Pipe in Survey Q-76-B.

Monuments and Accessories Found: (Condition and Source)

An Iron Pipe w. a 5" x 8" steel plate w/ an +, and a N for North.


A ^{5/8"} Iron rebar w/ypc 951LS lies S 4°15' E, 33.88'.

A ^{5/8"} Iron rebar w/ypc 951LS lies N 85°45' E, 48.19'.


A ^{5/8"} Iron rebar w/ypc 951LS lies N 18°45' E, 37.92'.

A ^{5/8"} Iron rebar w/ypc 951LS lies N 17°20' W, 99.52'.

Diagram

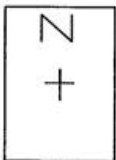

Sketch

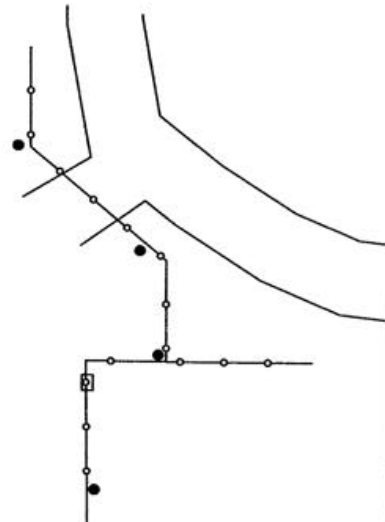

NAD 83/91
OREGON STATE PLANE NORTH
INTERNATIONAL FEET

N740318.61
E8538377.52
LAT - 45° 41' 23.169974" N
LON - 119° 11' 02.462385" W

Monument (s) Set (Procedures and Description)

None

References Set:

None

Location and Comments

The corner is at the end of a gravel road South of the Peircy Vineyard.

Compass Declination

17° E

Surveyors Seal

REGISTERED
PROFESSIONAL
LAND SURVEYOR

Robert D. English

OREGON
JANUARY 11, 2005
ROBERT DOUGLAS ENGLISH
43406LS

RENEWAL DATE: 12/31/11

RECEIVED BY:

Date: 2-10
Rec'd By: KK
No. 10-15-R

Firm / Agency

Survey One, LLC.
P.O. Box 382
Pendleton, OR 97801
(541) 276-2055