

OREGON CORNER RESTORATION FORM

Section 33,34 Township 3N
County Umatilla Date: 01/15/10

Range 29E

Corner Designation: 3N29Z13

Corner common to sections 33,34 T3NR29E, 3,4, T3NR28E.

- Condition Report Only
- Not Found
- Remonumented
- Unrecorded
- Surveyed In
- Referenced Out


Previous Renewals / Surveys, etc.

Originally Surveyed by David P. Thompson. He set a post in a mound of earth in 1859. Harris set a 3" Iron Pipe in Survey Q-76-B.


Monuments and Accessories Found: (Condition and Source)

- An Iron Pipe w. a 5" x 8" steel plate w/ an +, and a N for North.
- A 3/8" Iron rebar w/ypc 951LS lies S 4°15' E, 33.88'.
- A 3/8" Iron rebar w/ypc 951LS lies N 85°45' E, 48.19'.
- A 3/8" Iron rebar w/ypc 951LS lies N 18°45' E, 37.92'.
- A 3/8" Iron rebar w/ypc 951LS lies N 17°20' W, 99.52'.

Diagram

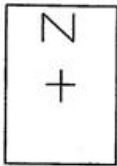

Sketch

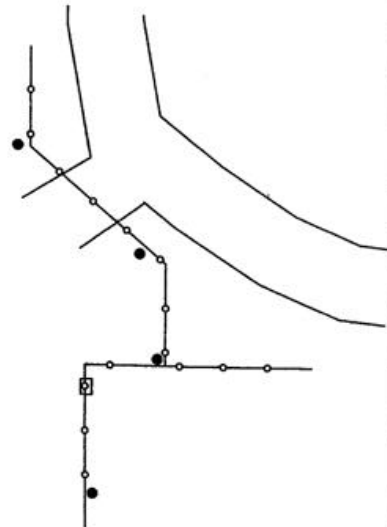

NAD 83/91
OREGON STATE PLANE NORTH
INTERNATIONAL FEET

N740314.26
E8538382.36
LAT - 45° 41' 23.12616" N
LON - 119° 11' 02.39531" W

Monument (s) Set (Procedures and Description)

None

References Set:

None

Location and Comments

The corner is at the end of a gravel road South of the Peircy Vineyard.

Compass Declination
17° E

Surveyors Seal

REGISTERED
PROFESSIONAL
LAND SURVEYOR

Robert D. English
OREGON
JANUARY 8, 2005
ROBERT DOUGLAS ENGLISH
43406LS

RENEWAL DATE: 12/31/11

RECEIVED BY:

Date: 1-11
Rec'd By: KR
No. 11-21-6

Firm / Agency

Survey One, LLC.
P.O. Box 382
Pendleton, OR 97801
(541) 276-2055