

# CORNER RESTORATION FORM

Township 3N & 4N Range 30E Section 3 & 34 County UMATILLA

State OREGON Date 10-8-2014 Number A-15

- Condition Report Only
- Not Found
- Renewed
- Surveyed In
- Referenced

Corner Designation : 1/4 SECTION 3 & 34

Previous Renewals ORIGINAL SOURCE OF CORNER


<u>UNDER GLO CONTRACT #84 BY N. GATES DATED</u>
<u>JULY 22, 1859 SET POST</u>
<u>Accessories Found:</u>
<u>NONE</u>

**BASIS OF BEARINGS, NAD 83/91 OREGON STATE PLANE  
COORDINATES NORTH ZONE:**

NORTHING: 772892.728  
EASTING: 8572604.604

### MONUMENT DETAIL


Found  Set

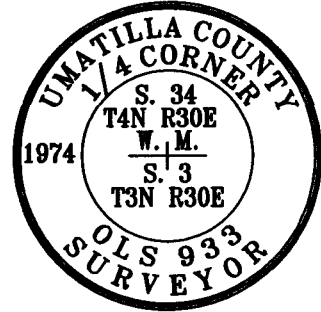

**Monument & Accessories Set (Procedure and Description)**

FOUND 2 1/2" BRASS CAP ABOVE GRADE. PER SURVEY No. I-162-B.

**Sketch of Monument, Accessories and General Area**

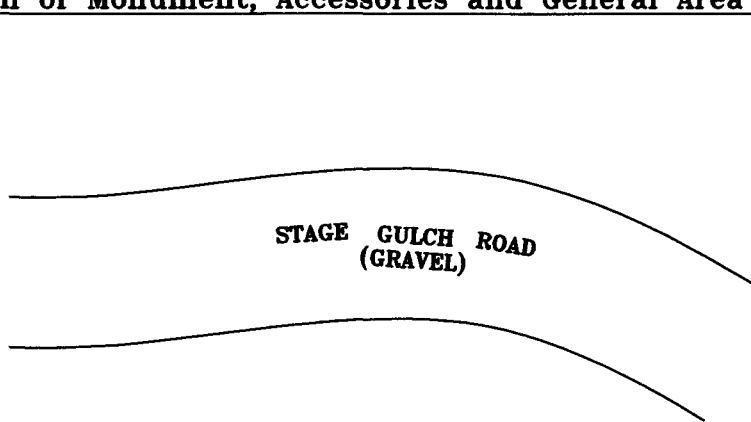

FOUND 2 1/2" BRASS  
CAP ABOVE GRADE.

**REGISTERED  
PROFESSIONAL  
LAND SURVEYOR**

*James King*  
**OREGON  
MAY 10, 2011  
LANCE CLARK KING  
61420**

**RENEWS: 6/30/2017**

**Agency:**

CK3, LLC  
945 W. ORCHARD  
HERMISTON OREGON 97838  
OFFICE: 541-567-2345  
FAX: 541-567-2305  
WEB: CK3LLC.NET  
Field Book # 0-298

**COUNTY SURVEYOR  
RECORDING INFO**

Received *May Hobart*  
Filed *6/12/2015*  
Survey No. *15-050-C*  
Drawing No. *C-853*  
Index No. A-15