

CORNER RESTORATION FORM

Township 3N Range 30E Section 3 & 10 County UMATILLA

State OREGON Date 4-2-2015 Number E-15

Corner Designation : 1/4 SECTION 3 & 10

- Condition Report Only
- Not Found
- Renewed
- Surveyed In
- Referenced

Previous Renewals ORIGINAL SOURCE OF CORNER


UNDER GLO CONTRACT #95 BY W. CAMPBELL DATED
SEPTEMBER 19, 1860 SET POST

Accessories Found:

NONE

MONUMENT DETAIL

Found Set

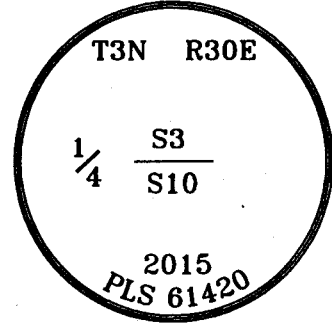

BASIS OF BEARINGS, NAD 83/91 OREGON STATE PLANE COORDINATES NORTH ZONE:

NORTHING: 767390.572
EASTING: 8572839.097

Monument & Accessories Set (Procedure and Description)

- SET 2 1/2" BRASS CAP ON 1 1/4"x30" PIPE 0.3' ABOVE GRADE, IN FENCE LINE.
- SET 5/8" REBAR & CAP PLS 61420 AT GRADE, N88°21'E 94.44', IN FENCE LINE BEARING OBJECT SIGN ON 6" TREATED POST.
- SET 5/8" REBAR & CAP PLS 61420 2' BELOW GRADE, S41°31'E 9.45', AT EDGE OF PLOWED FIELD.
- SET 5/8" REBAR & CAP PLS 61420 AT GRADE, S88°25'W 83.89', IN FENCE LINE BEARING OBJECT SIGN ON T-POST.
- SET 5/8" REBAR & CAP PLS 61420 2' BELOW GRADE, N22°44'W 54.80'.

Sketch of Monument, Accessories and General Area

REGISTERED PROFESSIONAL LAND SURVEYOR

Lance Clark King

OREGON
MAY 10, 2011
LANCE CLARK KING
61420

RENEWS: 6/30/2015

Agency:
CK3, LLC
945 W. ORCHARD
HERMISTON OREGON 97838
OFFICE: 541-567-2345
FAX: 541-567-2305
WEB: CK3LLC.NET
Field Book # 0-289

COUNTY SURVEYOR RECORDING INFO

Received *May Robert*

Filed 6/12/2015

Survey No. 15-050-C

Drawing No. C-853

Index No. E-15