

CORNER RESTORATION FORM

Township 3N Range 30E Section 3,2,10&11 County UMATILLA

State OREGON Date 4-7-2015 Number E-17

Corner Designation : SECTION 3, 2, 10 & 11

Condition Report Only
 Not Found
 Renewed
 Surveyed In
 Referenced


Previous Renewals ORIGINAL SOURCE OF CORNER

UNDER GLO CONTRACT #95 BY W. CAMPBELL DATED
SEPTEMBER 19, 1860 SET POST

Accessories Found:
NONE

MONUMENT DETAIL

Found Set

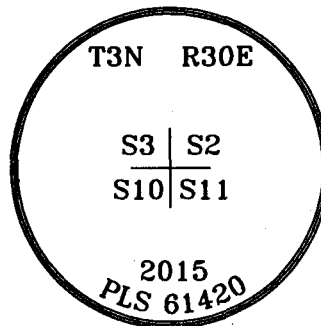

BASIS OF BEARINGS, NAD 83/91 OREGON STATE PLANE COORDINATES NORTH ZONE:

NORTHING: 767465.128
 EASTING: 8575499.358

Monument & Accessories Set (Procedure and Description)

- SET 2 1/2" BRASS CAP ON 1 1/4"x30" PIPE 0.5' ABOVE GRADE WEST SIDE OF WOOD POST SURVEY MARKER SIGN ON WOOD POST.
- SET 5/8" REBAR & CAP PLS 61420 AT GRADE, BEARING OBJECT SIGN ON WOOD POST, N6°39'E 8.26'.
- SET 5/8" REBAR & CAP PLS 61420 AT GRADE, IN FENCE LINE, N89°16'E 162.35'.
- SET 5/8" REBAR & CAP PLS 61420 2' BELOW GRADE , S39°09'W 4.98'.
- SET 5/8" REBAR & CAP PLS 61420 AT GRADE BEARING OBJECT SIGN ON WOOD POST, S89°14'W 72.68'.

Sketch of Monument, Accessories and General Area

ELECTRIC FENCE
 GRASSY PASTURE
 FIELD LINE
 FIELD
 REMNANTS OLD WIRE FENCE ON BERM
 SET 5/8" REBAR & CAP PLS 61420 AT GRADE, BEARING OBJECT SIGN ON WOOD POST
 SET 5/8" REBAR & CAP PLS 61420 AT GRADE, IN FENCE LINE
 SET 2 1/2" BRASS CAP ON 1 1/4"x30" PIPE 0.5' ABOVE GRADE WEST SIDE OF WOOD POST SURVEY MARKER SIGN ON WOOD POST
 SET 5/8" REBAR & CAP PLS 61420 2' BELOW GRADE
 BEARINGS AND DISTANCES: N6°39'E 8.26', N89°16'E 162.35', S89°14'W 72.68', S39°09'W 4.98'

REGISTERED PROFESSIONAL LAND SURVEYOR

Lance Clark King

OREGON
MAY 10, 2011
LANCE CLARK KING
61420

RENEWS: 6/30/2015

Agency:
CK3, LLC
945 W. ORCHARD
HERMISTON OREGON 97838
OFFICE: 541-567-2345
FAX: 541-567-2305
WEB: CK3LLC.NET
Field Book # 0-289

COUNTY SURVEYOR RECORDING INFO

Received *Doug Tubert*

Filed 6/12/2015

Survey No. 15-050-C

Drawing No. C-853

Index No. E-17