

# CORNER RESTORATION FORM

Township 3N Range 30E Section 5 & 8 County UMATILLA

State OREGON Date 4-9-2015 Number E-7

Corner Designation : 1/4 SECTION 5 & 8

Previous Renewals ORIGINAL SOURCE OF CORNER


UNDER GLO CONTRACT #81 BY D. THOMPSON DATED  
 JULY 8, 1859 SET POST

Accessories Found:  
 NONE

Condition Report Only  
 Not Found  
 Renewed  
 Surveyed In  
 Referenced

### MONUMENT DETAIL

Found  Set

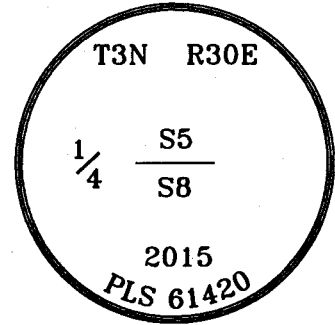

BASIS OF BEARINGS, NAD 83/91 OREGON STATE PLANE  
 COORDINATES NORTH ZONE:

NORTHING: 767258.607  
 EASTING: 8562279.587

### Monument & Accessories Set (Procedure and Description)

- SET 2 1/2" BRASS CAP ON 1 1/2" PIPE 2' BELOW GRADE IN FARM ROAD.
- SET 5/8" REBAR & CAP PLS 61420 1' BELOW GRADE, N29°17'E 18.51'.
- SET 5/8" REBAR & CAP PLS 61420 1' BELOW GRADE, S31°27'E 29.02'.
- SET 5/8" REBAR & CAP PLS 61420 1' BELOW GRADE, S35°07'W 25.30', WITH BEARING OBJECT SIGN ON GREEN STEEL POST.
- SET 5/8" REBAR & CAP PLS 61420 1' BELOW GRADE, N36°02'W 28.11'.

#### Sketch of Monument, Accessories and General Area

The sketch shows a central point with four bearings and distances to other monuments: N36°02'W 28.11' to the top-left, N29°17'E 18.51' to the top-right, S31°27'E 29.02' to the bottom-right, and S35°07'W 25.30' to the bottom-left. A 'DIRT FARM USE ROAD' is shown as a dashed line. A 'BEARING OBJECT SIGN ON GREEN STEEL POST' is located 12'± from the bottom-left monument. A north arrow is on the left. The area is labeled 'FIELD' in four corners.

**REGISTERED PROFESSIONAL LAND SURVEYOR**

*Lance Clark King*

**OREGON**  
MAY 10, 2011  
LANCE CLARK KING  
61420

**RENEWS: 6/30/2015**

Agency: CK3, LLC  
 945 W. ORCHARD  
 HERMISTON OREGON 97838  
 OFFICE: 541-567-2345  
 FAX: 541-567-2305  
 WEB: CK3LLC.NET  
 Field Book # 0-289

**COUNTY SURVEYOR RECORDING INFO**

Received *[Signature]*

Filed 6/12/2015

Survey No. 15-050-C

Drawing No. C-853

Index No. E-7