

CORNER RESTORATION FORM

Township 3N Range 30E Section 9 & 10 County UMATILLA

State OREGON Date 4-10-2015 Number G-13

Corner Designation : 1/4 SECTION 9 & 10

- Condition Report Only
- Not Found
- Renewed
- Surveyed In
- Referenced

Previous Renewals ORIGINAL SOURCE OF CORNER

UNDER GLO CONTRACT #81 BY D. THOMPSON DATED
JULY 8, 1859 SET POST

Accessories Found:


NONE

BASIS OF BEARINGS, NAD 83/91 OREGON STATE PLANE
 COORDINATES NORTH ZONE:

NORTHING: 764656.275
 EASTING: 8570254.834

MONUMENT DETAIL

Found Set

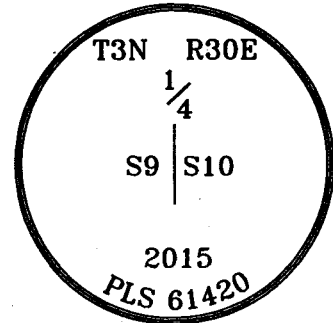

Monument & Accessories Set (Procedure and Description)

- SET 2 1/2" BRASS CAP ON 1 1/2" PIPE 1.8' BELOW GRADE IN FIELD.
- SET 5/8" REBAR & CAP PLS 61420 2' BELOW GRADE, N49°24'E 26.78'.
- SET 5/8" REBAR & CAP PLS 61420 2' BELOW GRADE, S37°07'E 30.72', WITH BEARING OBJECT SIGN ON GREEN STEEL POST.
- SET 5/8" REBAR & CAP PLS 61420 2' BELOW GRADE, S43°07'W 19.22'.
- SET 5/8" REBAR & CAP PLS 61420 2' BELOW GRADE, N39°57'W 14.40'.

Sketch of Monument, Accessories and General Area

SET 5/8" REBAR & CAP PLS 61420 2' BELOW GRADE

SET 5/8" REBAR & CAP PLS 61420 2' BELOW GRADE

SET 2 1/2" BRASS CAP ON 1 1/4"x30" PIPE AT 1.8' BELOW GRADE

SET 5/8" REBAR & CAP PLS 61420 2' BELOW GRADE

SET 5/8" REBAR & CAP PLS 61420 2' BELOW GRADE, BEARING OBJECT SIGN ON GREEN STEEL POST

REGISTERED PROFESSIONAL LAND SURVEYOR

Lance Clark King

OREGON
MAY 10, 2011
LANCE CLARK KING
61420

RENEWS: 6/30/2015

Agency:
CK3, LLC
945 W. ORCHARD
HERMISTON OREGON 97838
OFFICE: 541-567-2345
FAX: 541-567-2305
WEB: CK3LLC.NET
Field Book # 0-289

COUNTY SURVEYOR RECORDING INFO

Received *Doug Robert*

Filed 6/12/2015

Survey No. 15-050-C

Drawing No. C-853

Index No. G-13