

CORNER RESTORATION FORM

Township 3N Range 30E Section 10 & 15 County UMATILLA

State OREGON Date 4-7-2015 Number J-15

Corner Designation : 1/4 SECTION 10 & 15

Previous Renewals ORIGINAL SOURCE OF CORNER

UNDER GLO CONTRACT #95 BY W. CAMPBELL DATED
SEPTEMBER 19, 1860 SET POST

Accessories Found:

NONE


BASIS OF BEARINGS, NAD 83/91 OREGON STATE PLANE
 COORDINATES NORTH ZONE:

NORTHING: 762010.218
 EASTING: 8572918.446

- Condition Report Only
- Not Found
- Renewed
- Surveyed In
- Referenced

MONUMENT DETAIL

Found Set

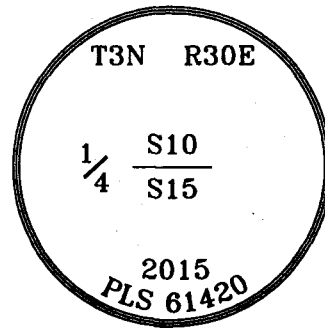

Monument & Accessories Set (Procedure and Description)

- SET 2 1/2" BRASS CAP ON 1 1/4"x30" PIPE 2' BELOW GRADE, SURVEY MARKER SIGN ON GREEN STEEL POST.
- SET 5/8" REBAR & CAP PLS 61420 2' BELOW GRADE, N42°02'E 15.16'.
- SET 5/8" REBAR & CAP PLS 61420 2' BELOW GRADE, BEARING OBJECT SIGN ON GREEN STEEL POST, S34°30'E 19.04'.
- SET 5/8" REBAR & CAP PLS 61420 2' BELOW GRADE, S33°28'W 24.98'.
- SET 5/8" REBAR & CAP PLS 61420 2' BELOW GRADE, N57°21'W 9.77'.

<p style="text-align: center;"><u>Sketch of Monument, Accessories and General Area</u></p> <p>The sketch shows a central monument point with five lines radiating to other markers. The markers and their bearings/distances are: <ul style="list-style-type: none"> Top-right: SET 5/8" REBAR & CAP PLS 61420 2' BELOW GRADE, N42°02'E 15.16' Bottom-right: SET 5/8" REBAR & CAP PLS 61420 2' BELOW GRADE BEARING OBJECT SIGN ON GREEN STEEL POST, S34°30'E 19.04' Bottom: SET 5/8" REBAR & CAP PLS 61420 2' BELOW GRADE, S33°28'W 24.98' Bottom-left: SET 5/8" REBAR & CAP PLS 61420 2' BELOW GRADE, N57°21'W 9.77' Top-left: SET 5/8" REBAR & CAP PLS 61420 2' BELOW GRADE, N42°02'E 15.16' A dashed line labeled 'FIELD DIVISION' passes through the monument. The area is labeled 'FIELD' and 'GRASSY PASTURE'. A north arrow is also present. </p>	<div style="border: 1px solid black; padding: 5px; text-align: center;"> <p>REGISTERED PROFESSIONAL LAND SURVEYOR</p> <p><i>Lance Clark King</i></p> <p>OREGON MAY 10, 2011 LANCE CLARK KING 61420</p> </div> <p>RENEWS: 6/30/2015</p> <p>Agency: CK3, LLC 945 W. ORCHARD HERMISTON OREGON 97838 OFFICE: 541-567-2345 FAX: 541-567-2305 WEB: CK3LLC.NET Field Book # 0-289</p> <p style="text-align: center;">COUNTY SURVEYOR RECORDING INFO</p> <p>Received <u><i>Dan Phet</i></u> Filed <u><i>6/12/2015</i></u> Survey No. <u><i>15-050-C</i></u> Drawing No. <u><i>C-853</i></u> Index No. <u>J-15</u></p>
---	---