

CORNER RESTORATION FORM

Township 3N Range 30E Section 7 & 18 County UMATILLA

State OREGON Date 3-12-2015 Number J-3

Corner Designation : 1/4 SECTION 7 & 18

- Condition Report Only
- Not Found
- Renewed
- Surveyed In
- Referenced

Previous Renewals ORIGINAL SOURCE OF CORNER


UNDER GLO CONTRACT #95 BY W. CAMPBELL DATED
SEPTEMBER 19, 1860 SET POST

Accessories Found:

NONE

MONUMENT DETAIL

Found Set

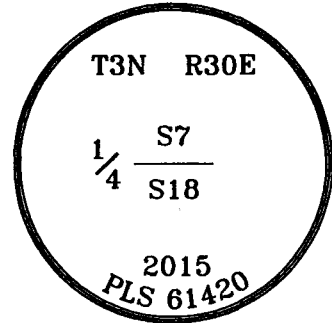

BASIS OF BEARINGS, NAD 83/91 OREGON STATE PLANE
 COORDINATES NORTH ZONE:

NORTHING: 761935.741
 EASTING: 8557155.785

Monument & Accessories Set (Procedure and Description)

- SET 2 1/2" BRASS CAP ON 1 1/4"x30" PIPE 2" BELOW PAVEMENT.
- SET PK & WASHER PLS 61420 IN POWER POLE, N12°08'E 64.67', AND BEARING OBJECT SIGN ON POWER POLE.
- FOUND ALUMINUM ODOT R-O-W MONUMENT, S71°14'E 80.94', MARKED R/W SHRW STA. 'ER' INTSECTION MONUMENT 80' RT.
- FOUND ALUMINUM ODOT R-O-W MONUMENT, S70°33'W 94.42', MARKED R/W SHRW STA. 'ER' INTSECTION MONUMENT 80' LT.
- SET PK & WASHER PLS 61420 IN POWER POLE, N30°04'W 66.75', AND BEARING OBJECT SIGN ON POWER POLE.

<p style="text-align: center;"><u>Sketch of Monument, Accessories and General Area</u></p> <p>The sketch shows a central monument point with four bearings and distances to other points: - To top-left: N30°04'W 66.75' (to power pole) - To top-right: N12°08'E 64.67' (to power pole) - To bottom-left: S70°33'W 94.42' (to 'ER' intersection monument) - To bottom-right: S71°14'E 80.94' (to 'ER' intersection monument)</p> <p>Roads shown include MEYERS RD, WELLS STATION RD, WHITMORE RD, and TO FREEWAY I-84. Other features include 'FIELD' areas and 'OHP' (Overhead Power) lines.</p>	<div style="border: 1px solid black; padding: 5px; text-align: center;"> <p>REGISTERED PROFESSIONAL LAND SURVEYOR</p> <p><i>Lance Clark King</i></p> <p>OREGON MAY 10, 2011 LANCE CLARK KING 61420</p> <p>RENEWS: 6/30/2015</p> </div> <div style="border: 1px solid black; padding: 5px;"> <p>Agency: CK3, LLC 945 W. ORCHARD HERMISTON OREGON 97838 OFFICE: 541-567-2345 FAX: 541-567-2305 WEB: CK3LLC.NET Field Book # 0-289</p> </div> <div style="border: 1px solid black; padding: 5px;"> <p style="text-align: center;">COUNTY SURVEYOR RECORDING INFO</p> <p>Received <i>Jay Robert</i></p> <p>Filed <u>6/12/2015</u></p> <p>Survey No. <u>15-050-C</u></p> <p>Drawing No. <u>C-853</u></p> <p>Index No. <u>J-3</u></p> </div>
--	---