

CORNER RESTORATION FORM

Township 3N Range 30E Section 15 & 22 County UMATILLA

State OREGON Date 4-22-2015 Number N-15

Corner Designation : 1/4 SECTION 15 & 22

- Condition Report Only
- Not Found
- Renewed
- Surveyed In
- Referenced

Previous Renewals ORIGINAL SOURCE OF CORNER


UNDER GLO CONTRACT #95 BY W. CAMPBELL DATED
SEPTEMBER 19, 1860 SET POST

Accessories Found:

NONE

MONUMENT DETAIL

Found Set

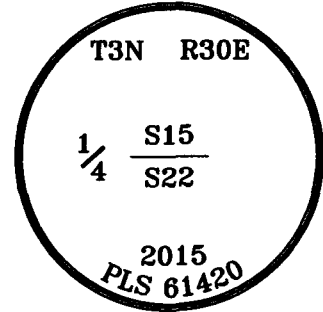

BASIS OF BEARINGS, NAD 83/91 OREGON STATE PLANE COORDINATES NORTH ZONE:

NORTHING: 756883.911
 EASTING: 8573022.626

Monument & Accessories Set (Procedure and Description)

- SET 2 1/2" BRASS CAP ON 1 1/4"x30" PIPE 2' BELOW FIELD GRADE, SET SURVEY MAKER SIGN ON GREEN STEEL POST.
- SET 5/8" REBAR & CAP PLS 61420 AT GRADE, N54°39'E 33.11', SET BEARING OBJECT SIGN ON GREEN STEEL POST.
- SET 5/8" REBAR & CAP PLS 61420 AT GRADE, S59°01'E 30.86', SET BEARING OBJECT SIGN ON GREEN STEEL POST.
- SET 5/8" REBAR & CAP PLS 61420 1.5' BELOW GRADE, S21°34'W 24.47'.
- SET 5/8" REBAR & CAP PLS 61420 1.5' BELOW GRADE, N31°58'W 21.94'.

Sketch of Monument, Accessories and General Area

REGISTERED PROFESSIONAL LAND SURVEYOR

Lance Clark King

OREGON
MAY 10, 2011
LANCE CLARK KING
61420

RENEWS: 6/30/2017

Agency:
CK3, LLC
945 W. ORCHARD
HERMISTON OREGON 97838
OFFICE: 541-567-2345
FAX: 541-567-2305
WEB: CK3LLC.NET
Field Book # 0-298

COUNTY SURVEYOR RECORDING INFO

Received *Jay Robert*

Filed 6/12/2015

Survey No. 15-050-C

Drawing No. C-853

Index No. N-15