

CORNER RESTORATION FORM

Township 3N Range 30E Section 14,13,23&24 County UMATILLA

State OREGON Date 4-22-2015 Number N-21

Corner Designation : SECTION 14, 13, 23 & 24

- Condition Report Only
- Not Found
- Renewed
- Surveyed In
- Referenced

Previous Renewals ORIGINAL SOURCE OF CORNER

UNDER GLO CONTRACT #95 BY W. CAMPBELL DATED
SEPTEMBER 19, 1860 SET POST

Accessories Found:


NONE

BASIS OF BEARINGS, NAD 83/91 OREGON STATE PLANE COORDINATES NORTH ZONE:

NORTHING: 757059.302
 EASTING: 8580999.147

MONUMENT DETAIL

Found Set

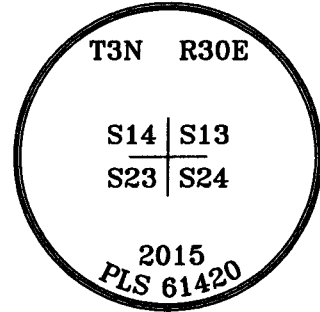

Monument & Accessories Set (Procedure and Description)

- SET 2 1/2" BRASS CAP ON 1 1/4"x30" PIPE 0.7 BELOW GRADE, SET SURVEY MARKER SIGN ON GREEN STEEL POST.
- SET 5/8" REBAR & CAP PLS 61420 AT GRADE, N86°57'E 8.19', SET BEARING OBJECT SIGN ON RAILROAD TIE POST.
- SET 5/8" REBAR & CAP PLS 61420 AT GRADE, S37°51'E 18.65', NEAR TELEPHONE PEDESTAL.
- SET PK & WASHER PLS 61420 IN POWER POLE, S47°55'W 30.95', SET BEARING OBJECT SIGN ON POWER POLE.
- SET 5/8" REBAR & CAP PLS 61420 AT GRADE, N51°13'W 46.08', SET BEARING OBJECT SIGN ON GREEN STEEL POST.

Sketch of Monument, Accessories and General Area

MCLINTOCK-LORENZEN ROAD

REGISTERED PROFESSIONAL LAND SURVEYOR

Lance Clark King

OREGON
MAY 10, 2011
LANCE CLARK KING
61420

RENEWS: 6/30/2017

Agency:
CK3, LLC
945 W. ORCHARD
HERMISTON OREGON 97838
OFFICE: 541-567-2345
FAX: 541-567-2305
WEB: CK3LLC.NET
Field Book # 0-298

COUNTY SURVEYOR RECORDING INFO

Received *Day Mist*

Filed 6/12/2015

Survey No. 15-050-C

Drawing No. C-853

Index No. N-21