

# CORNER RESTORATION FORM

Township 3N Range 30E Section 13,14,19&24 County UMATILLA

State OREGON Date 10-6-2014 Number N-25

- Condition Report Only
- Not Found
- Renewed
- Surveyed In
- Referenced

Corner Designation : SECTION 13, 14, 19 & 24

Previous Renewals ORIGINAL SOURCE OF CORNER

UNDER GLO CONTRACT #84 BY N. GATES DATED  
JULY 22, 1859 SET POST

Accessories Found:


NONE

BASIS OF BEARINGS, NAD 83/91 OREGON STATE PLANE  
 COORDINATES NORTH ZONE:

NORTHING: 757233.539  
 EASTING: 8586213.916

## MONUMENT DETAIL

Found  Set

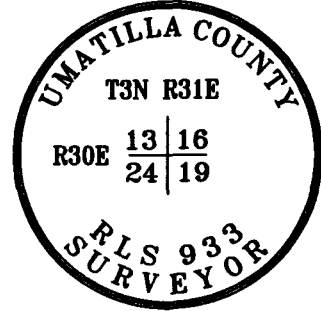

### Monument & Accessories Set (Procedure and Description)

FOUND 2 1/4" BRASS CAP 6" BELOW ROAD GRADE. PER SURVEY No. 06-462-C.

<p><u>Sketch of Monument, Accessories and General Area</u></p>	<div style="border: 1px solid black; padding: 5px; text-align: center;"> <p><b>REGISTERED PROFESSIONAL LAND SURVEYOR</b></p> <p><i>Lance Clark King</i></p> <p><b>OREGON</b>  <b>MAY 10, 2011</b>  <b>LANCE CLARK KING</b>  <b>61420</b></p> <p><b>RENEWS: 6/30/2017</b></p> <p><b>Agency:</b>                  CK3, LLC                  945 W. ORCHARD                  HERMISTON OREGON 97838                  OFFICE: 541-567-2345                  FAX: 541-567-2305                  WEB: CK3LLC.NET                  Field Book # 0-298</p> <p><b>COUNTY SURVEYOR RECORDING INFO</b></p> <p>Received <i>Jay Robert</i></p> <p>Filed <u>6/12/2015</u></p> <p>Survey No. <u>15-050-C</u></p> <p>Drawing No. <u>C-853</u></p> <p>Index No. <u>N-25</u></p> </div>
--	---