

# CORNER RESTORATION FORM

Township 3N Range 30E Section 18 & 19 County UMATILLA

State OREGON Date 4-28-2015 Number N-3

Corner Designation : 1/4 SECTION 18 & 19

- Condition Report Only
- Not Found
- Renewed
- Surveyed In
- Referenced

Previous Renewals ORIGINAL SOURCE OF CORNER


UNDER GLO CONTRACT #81 BY D. THOMPSON DATED  
JULY 8, 1859 SET POST  
   
   
 

Accessories Found:

NONE

### MONUMENT DETAIL

Found  Set

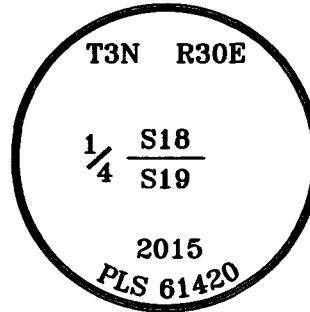

BASIS OF BEARINGS, NAD 83/91 OREGON STATE PLANE COORDINATES NORTH ZONE:

NORTHING: 756669.082  
 EASTING: 8557247.690

### Monument & Accessories Set (Procedure and Description)

SET 2 1/2" BRASS CAP ON 1 1/4"x30" PIPE 2' BELOW GRADE IN FIELD, SET SURVEY MARKER SIGN ON GREEN STEEL POST.


SET 5/8" REBAR & CAP PLS 61420 1.5' BELOW GRADE, N35°16'E 20.73'.

SET 5/8" REBAR & CAP PLS 61420 1.5' BELOW GRADE, S40°50'E 11.81'.

SET 5/8" REBAR & CAP PLS 61420 1.5' BELOW GRADE, S50°43'W 12.27'.

SET 5/8" REBAR & CAP PLS 61420 1.5' BELOW GRADE, N20°22'W 17.95'.

### Sketch of Monument, Accessories and General Area

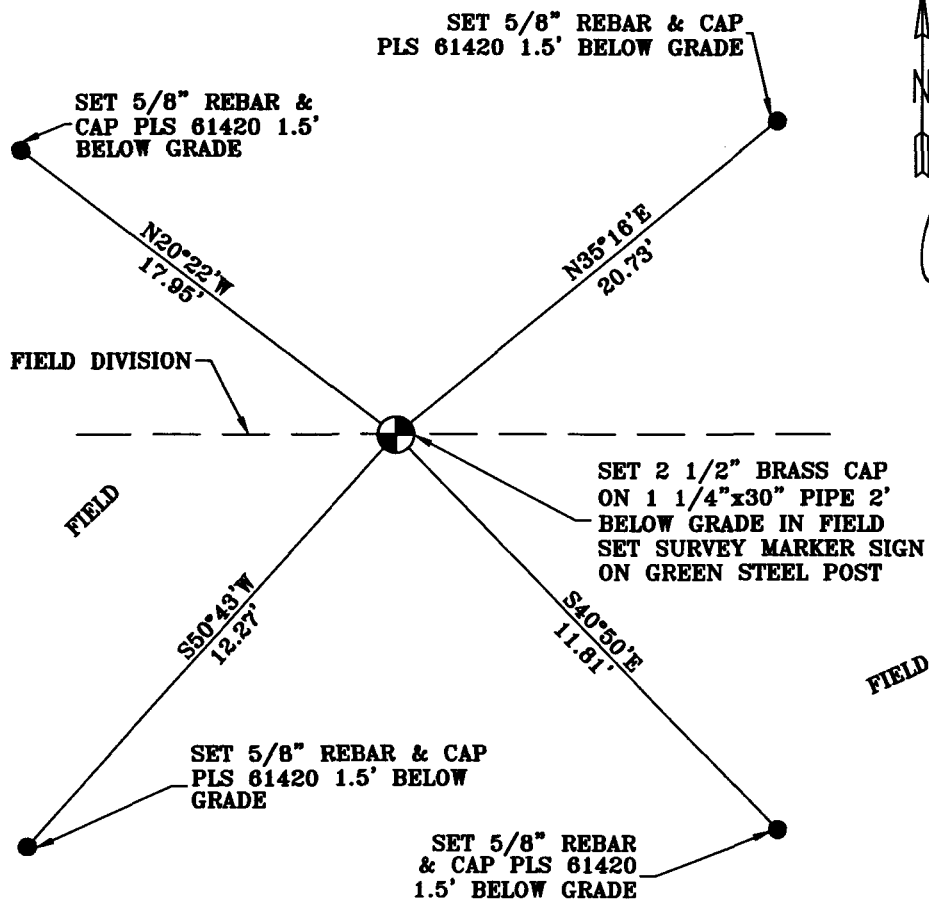

**REGISTERED PROFESSIONAL LAND SURVEYOR**

*Lance Clark King*

**OREGON**  
MAY 10, 2011  
**LANCE CLARK KING**  
61420

**RENEWS: 6/30/2017**

**Agency:**  
CK3, LLC  
945 W. ORCHARD  
HERMISTON OREGON 97838  
OFFICE: 541-567-2345  
FAX: 541-567-2305  
WEB: CK3LLC.NET  
Field Book # 0-298

**COUNTY SURVEYOR RECORDING INFO**

Received *Jay Robert*

Filed 6/12/2015

Survey No. 15-050-C

Drawing No. C-853

Index No. N-3