

CORNER RESTORATION FORM

Township 3N Range 30E Section 19 & 20 County UMATILLA

State OREGON Date 4-28-2015 Number P-5

Corner Designation : 1/4 SECTION 19 & 20

- Condition Report Only
- Not Found
- Renewed
- Surveyed In
- Referenced

Previous Renewals ORIGINAL SOURCE OF CORNER


UNDER GLO CONTRACT #81 BY D. THOMPSON DATED
JULY 8, 1859 SET POST

Accessories Found:

NONE

MONUMENT DETAIL

Found Set

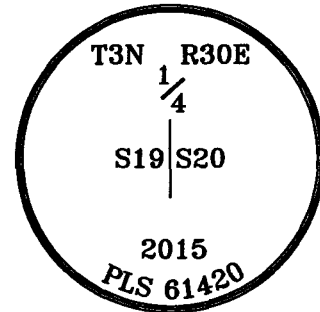

BASIS OF BEARINGS, NAD 83/91 OREGON STATE PLANE COORDINATES NORTH ZONE:

NORTHING: 754071.026
 EASTING: 8559924.468

Monument & Accessories Set (Procedure and Description)

- SET 2 1/2" BRASS CAP ON 1 1/4"x16" PIPE 0.7 BELOW GRADE IN ROAD DRIVEN IN HARD PAN.
- SET 5/8" REBAR & CAP PLS 61420 AT GRADE ON ROAD BANK, N79°30'E 45.39'.
- SET 5/8" REBAR & CAP PLS 61420 AT GRADE NW CORNER TIN ROOF WILDLIFE WATERER, S35°47'E 78.53'.
- SET 5/8" REBAR & CAP PLS 61420 AT GRADE, SET BEARING OBJECT SIGN ON GREEN STEEL POST, S43°46'W 26.10'.
- SET 5/8" REBAR & CAP PLS 61420 AT GRADE, N72°03'W 27.70'.

Sketch of Monument, Accessories and General Area

The sketch shows a central point representing the corner. Four monuments are set around it with the following bearings and distances:

- N72°03'W 27.70' to a 5/8" rebar & cap on the road bank.
- N79°30'E 45.39' to another 5/8" rebar & cap on the road bank.
- S43°46'W 26.10' to a 5/8" rebar & cap on a green steel post.
- S35°47'E 78.53' to a 5/8" rebar & cap at the NW corner of a tin roof wildlife waterer.

A dirt farm road is shown with a 2 1/2" brass cap on a 1 1/4" x 16" pipe 0.7' below grade. A north arrow is present, and a 16'± distance is marked between the road and the waterer.

REGISTERED PROFESSIONAL LAND SURVEYOR

Lance Clark King

OREGON
MAY 10, 2011
LANCE CLARK KING
61420

RENEWS: 6/30/2017

Agency:
CK3, LLC
945 W. ORCHARD
HERMISTON OREGON 97838
OFFICE: 541-567-2345
FAX: 541-567-2305
WEB: CK3LLC.NET
Field Book # 0-298

COUNTY SURVEYOR RECORDING INFO

Received Doug Weber

Filed 6/12/2015

Survey No. 15-050-C

Drawing No. C-853

Index No. P-5