

OREGON CORNER RESTORATION FORM

Section 36 Township 3N Range 29E
County Umatilla Date: 05/05/09

Corner Designation: 3N29X25

1/4 corner common to sections 36, T3NR29E, 31, T3NR30E.

- Condition Report Only
- Not Found
- Remonumented
- Unrecorded
- Surveyed In
- Referenced Out

Previous Renewals / Surveys, etc.


Originally Surveyed by David P. Thompson in 1859. He set a post in a mound of earth.

Monuments and Accessories Found: (Condition and Source)

Diagram



Sketch

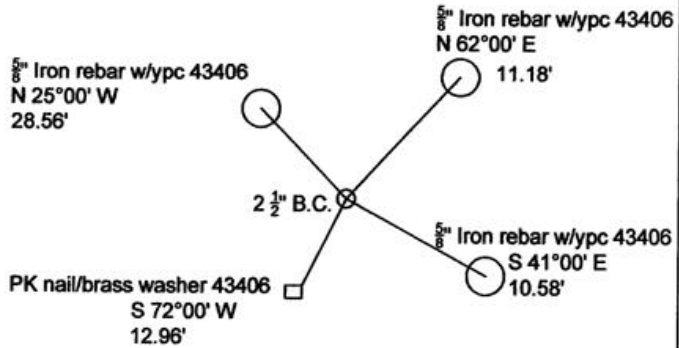

NAD 83/91
OREGON STATE PLANE NORTH
INTERNATIONAL FEET

N743343.02
E8554213.09

LAT - 45° 41' 50.4194" N
LON - 119° 07' 18.6838" W

Monument (s) Set (Procedures and Description)

Set A 1"x30" flared galvanized iron pipe with a 2 1/2" B.C. by single proportion from SE Township corner and old fence corner at the NE corner of section 36.

References Set:

- A 5/8" x 30" Iron rebar w/ypc #43406 12" deep lies N 62°00' E, 11.18'
- A 5/8" x 30" Iron rebar w/ypc #43406 12" deep lies S 41°00' E, 10.58'
- A PK nail and Brass washer #43406 on a railroad tie fence post lies S 72°00' W, 12.96'.
- A 5/8" x 30" Iron rebar w/ypc #43406 and tee post lies N 25°00' W, 28.56'.

Location and Comments

The corner is in the north edge of the Oregon Trail and is 1/2 mile north of the Umatilla River.

Compass Declination
17° E

Surveyors Seal

REGISTERED
PROFESSIONAL
LAND SURVEYOR

Robert D. English
OREGON
JANUARY 11, 2005
ROBERT DOUGLAS ENGLISH
43406LS

RECEIVED BY:

Date: 5-09
Rec'd By: RE
No. 09-81-R

Firm / Agency

Survey One, LLC.
P.O. Box 382
Pendleton, OR 97801
(541) 276-2055

RENEWAL DATE: 12/31/09