

**OREGON CORNER RESTORATION FORM**

Section 32 Township 3N Range 30E  
 County Umatilla Date: September 14, 2016

Corner Designation: <sup>**Z5**</sup>  
 3N30~~W~~5

Condition Report Only  
 Not found  
 Remonumented  
 Unrecorded  
 Surveyed in  
 Referenced out

Corner to sections 30 & 31 T3N and sections 5 & 6,  
 T2N, R30E, W.M., Umatilla County, Oregon.


Previous Renewals / Surveys, etc.

Corner was originally set by David P. Thompson under contract No. 83 dated July 22, 1859.  
 His record reads: Set post for corner to Secs. 5, 6, 32, and 33 in mound of earth and stone. In  
 survey Q-515-Ax, Elmo Robnette tied this corner but did not identify the monument.

Monument and Accessories found: ( condition and source )

A porous red basalt stone set in an east-west fence in line with possessory lines to the south. The  
 remains of a stone mound are scattered about at this point.


**DIAGRAM**

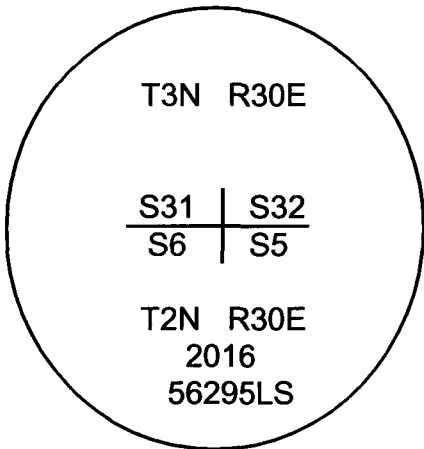

⊙ = Brass Cap

✕ = Rebar Reference

**SKETCH**

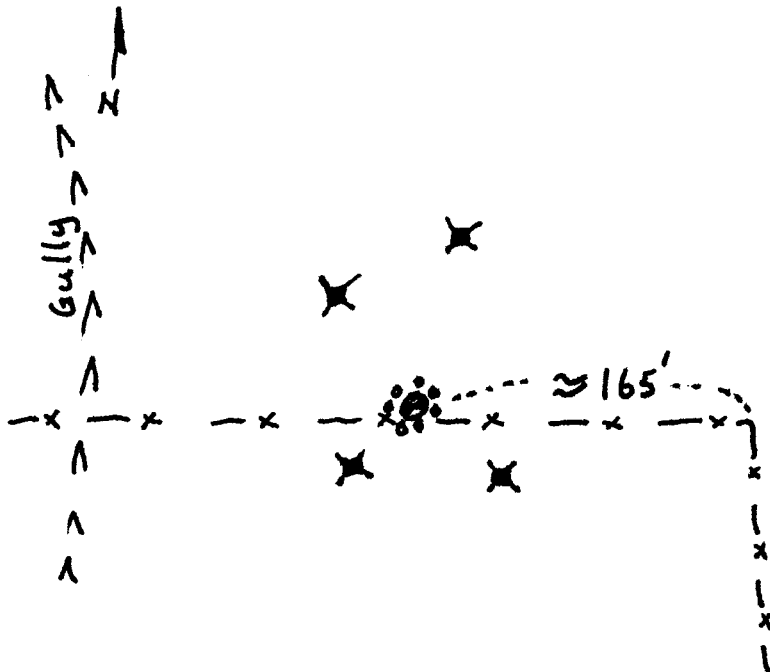

**MONUMENT (S) AND ACCESSORIES SET (Procedures and Description)**

At the position of the stone in the fence line I drilled a hole 6 inches in the bedrock and cemented a 5/8"x12" iron rebar over which I cemented a 1 1/2"x10" galvanized iron pipe with a 2 3/8" brass cap attached stamped as shown in the diagram above. The cap is about 2 inches above the surface with a small mound of stone around it.

For references I set four 5/8" x 24" iron rebars with orange plastic caps attached stamped WTS and 56295LS as described below:

- An iron rebar bears S45°45'44"E 34.54 feet;
- An iron rebar bears S61°31'05"W 22.36 feet;
- An iron rebar bears N39°23'41"W 40.68 feet;
- An iron rebar bears N11°51'29"E 54.52 feet;

The monument was tied using a Trimble R7/R8 RTK GPS system.

Location and comments

Compass Declination

Surveyors Seal

RECEIVED BY:

Umatilla County Surveyor

Date: 2/2/2017

Rec'd By: [Signature]

No. 17-005-43

Firm / Agency

Witness Tree Surveying



Address

P.O. Box G

Pilot Rock, Or. 97868

Party Chief

Stephen K, Haddock

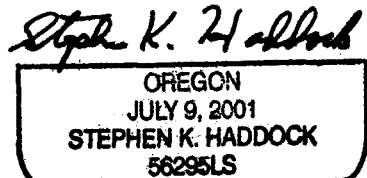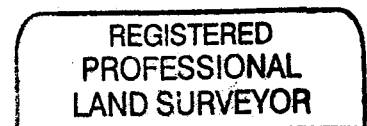

RENEWS: 6-30-17