

OREGON CORNER RESTORATION FORM

COUNTY: Umatilla

DATE: 02/24/10

CORNER DESIGNATION: 3N31, X-13, The West One-Quarter of Section 34.

PREVIOUS RENEWAL/SURVEYS ETC.

This corner was originally established by D.S. Payne under contract no. 100, dated August 1, 1861. Record states: Set charred stake with mound, trench & pits as per insts. for 1/4 section corner.

Corner was re-established by William R. Wells with subsequent Monumentation record dated: 04/04/06. Record states "At reestablished corner position, set a 2 3/8" brass cap on 1 1/4" by 30" galvanized iron pipe with cap 12" below gravel road surface."

MONUMENT AND ACCESSORIES FOUND:

Prior to road construction, found and tied brass cap. Cap was undisturbed and as described in prior Monumentation record. After road construction, a search was made for the monument and only the flanges of the pipe were found. Also, all of the accessories set at the same time of Wells re-establishment of the corner were found undisturbed and are listed below.

MONUMENTS SET:



At the position of the re-established corner I set a 1" I.D. by 30" galvanized iron pipe with 2 1/2" brass cap buried 12" below roadway surface, marked as shown for the East 1/4 Section 33. From which:

An existing 5/8" x 24" iron rebar with 1 1/4" red plastic cap marked "OR PLS 1106 WA PLS 17372" bears North 12° West, 60.5 feet.

An existing 5/8" x 24" iron rebar with 1 1/4" red plastic cap marked "OR PLS 1106 WA PLS 17372" bears North 41° West, 25.9 feet.

An existing 5/8" x 24" iron rebar with 1 1/4" red plastic cap marked "OR PLS 1106 WA PLS 17372" bears South 49 1/2° West, 23.4 feet.

An existing 5/8" x 24" iron rebar with 1 1/4" red plastic cap marked "OR PLS 1106 WA PLS 17372" bears South 19 1/2° West, 59.0 feet

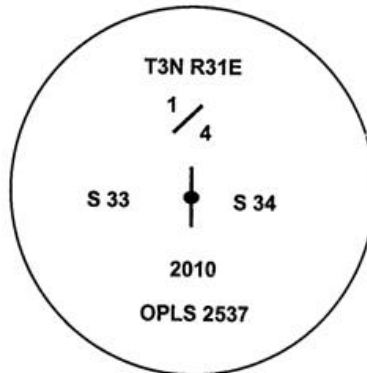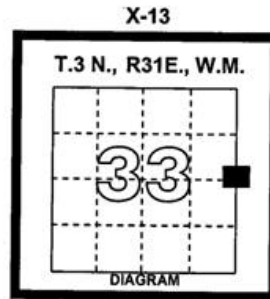

LOCATION AND COMMENTS: Corner is located in the westerly side of the gravel road where the re-aligned Barnhart road joins the old Barnhart road.

COMPASS DECLINATION: 18° EAST

OREGON STATE PLANE COORDINATE, NORTH ZONE, NAD 83(91), INTERNATIONAL FEET

Northing Easting
744061.08 8602380.98

(Coordinate is from William R. Well's Monumentation record re-establishing this corner. 04/04/06)

FIRM: Anderson Perry & Associates
1901 N. Fir St.
La Grande, OR 97850

I hereby certify that the above corner position was perpetuated as hereon described on February 24th, 2010.

Witnesses: Gary L. Langlitz PLS, Jeffrey A. Madsen PLS

REGISTERED
PROFESSIONAL
LAND SURVEYOR

H. M. [Signature]
OREGON
JULY 21, 1983
HARMON E. McLENDON
2537

renews 12/31/11

RECEIVED BY

3-10
KK
10 22 10