

OREGON CORNER RESTORATION FORM

COUNTY: Umatilla DATE: 07/15/13

CORNER DESIGNATION: 3N32, A03, The North One-Quarter Corner of Section 6.

PREVIOUS RENEWALS/SURVEYS ETC.: Corner originally established by David Thompson, under GLO Contract 106, dated August 1864, notes state: Set post for 1/4 Sec. corner in mound of Earth with charred stake, pits, trench &c as per instructions.

MONUMENT AND ACCESSORIES FOUND: None.

MONUMENT MARKING DETAIL:

T4N R32E
1 S31
4 S6
T3N
2013
PLS 54657

MONUMENT SET: Held the intersection of the Westerly projection of the County Road with a old field line South as best remaining evidence of the original corner position. At said point, set a 2 3/8" brass cap on a 1 1/4" x 30" galvanized iron pipe, with cap 20 inches below ground level, stamped as stated in "Monument Marking Detail", from which:

- A silver deep 1 magnet, buried 20" below ground, bears North 37° East, 41.7 feet.
- A pink deep 1 magnet, buried 20" below ground, bears South 71° East, 43.2 feet.
- A blue deep 1 magnet, buried 20" below ground, bears South 37° West, 34.6 feet.
- An orange deep 1 magnet, buried 20" below ground, bears North 68° West, 35.1 feet.

Attached bearing object signs to all accessories.

LOCATION AND COMMENTS: Falls in a farmed field with field line projection South and centerline of road East.

OREGON STATE PLANE COORDINATE, North Zone, NAD 83(91), International Feet:

N= 773324.37'
E= 8620695.87'


FIRM: Wells Surveying
P.O. Box 1696
Pendleton, OR 97801

COMPASS DECLINATION: 18° East

Surveyor's Seal

Witnesses: Jason Wells, PLS
Dean Roy

\3N32A03

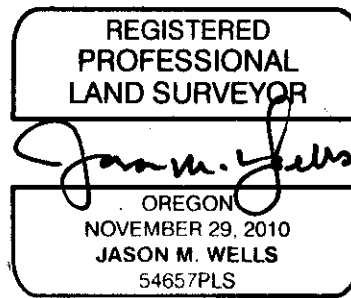

RENEWS: 6-30-14