

OREGON CORNER RESTORATION FORM

Section 6 Township 3N Range 33E
County Umatilla Date: 03/15/11

Corner Designation: 3N33C1

1/4 corner common to sections 6, T3NR33E, 1,
T3NR32E.

____ Condition Report Only
X ____ Not Found
____ Remonumented
____ Unrecorded
X ____ Surveyed In
X ____ Referenced Out

Previous Renewals / Surveys, etc.

Originally Surveyed by Thompson in 1864. He set a post in a mound of earth.


Monuments and Accessories Found: (Condition and Source)

None.

Diagram



Sketch

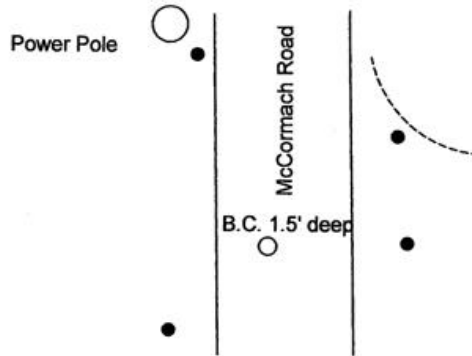

NAD 83/91
OREGON STATE PLANE NORTH
INTERNATIONAL FEET

N771239.96
E8649834.73

Monument (s) Set (Procedures and Description)

Set a 2 1/2" Brass cap on a 1 1/8" x 30" galvanized iron pipe 18 inches below the surface, by single proportionate method and holding an ancient juniper fence post at the end of the field line at the road (for Northing).

References Set:

- A Silver magnet, 20" deep, lies N 48°30' E, 40.87'.
- A 1/8" Iron rebar w/rpc #43406 lies N 88°50' E, 34.86'.
- A Blue magnet, 20" deep, lies S 43°50' W, 18.08'.
- A 1/8" Iron rebar w/rpc #43406 lies N 12°20' W, 60.80'.

Location and Comments

From the intersection of Midway
Road and McCormach Road, go
0.5 miles South.

Compass Declination

17° E

Surveyors Seal

REGISTERED
PROFESSIONAL
LAND SURVEYOR

Robert D. English
OREGON
JANUARY 11, 2005
ROBERT DOUGLAS ENGLISH
43406LS

RECEIVED BY:

Date: _____
Rec'd By: _____
No. _____

Firm / Agency

Survey One, LLC.
P.O. Box 382
Pendleton, OR 97801
(541) 276-2055

RENEWAL DATE: 12/31/11