

OREGON CORNER RESTORATION FORM

COUNTY: Umatilla DATE: 05/30/13

CORNER DESIGNATION: 3N32, L21, The East One-Quarter Corner of Section 14.

PREVIOUS RENEWALS/SURVEYS ETC.: Corner originally established by David Chaplin, under GLO Contract 107, dated September 1864, notes state: Set post for 1/4 Sec. cor. in mound of earth with charred stake pits & as per instructions. Old County Road notes generally indicate the road is along the section line. 1956 USDA Farm Service photos clearly show a substantial "jog" in the road near this corner.

MONUMENT AND ACCESSORIES FOUND: None.

MONUMENT MARKING DETAIL:

T3N R32E
1/4
S14|S13
2013
PLS 54657

MONUMENT SET: Determined the midpoint of a line between the Southeast and Northeast corners of Section 14 and extended from said mid-point due East to intersect the County Road centerline. Held this point as the best remaining evidence of the original corner position. Note: using a straight single proportion would cut through improvements constructed on an old farmstead on the West side of the County Road. At the reestablished corner position, set a 2 3/8" brass cap on a 1 1/4" x 30" galvanized iron pipe, stamped as stated in "Monument Marking Detail", from which:

A 3/4" brass washer stamped "PLS 1106" in fence post bears North 29 1/2° East, 37.0 feet.

A 3/4" brass washer stamped "PLS 1106" in fence post bears South 37° East, 29.4 feet.

A 5/8" x 24" rebar with 1 1/4" purple plastic cap stamped "Wells Surveying, PLS 54657", in road bank, bears South 30° West, 33.0 feet.

A 5/8" x 24" rebar with 1 1/4" purple plastic cap stamped "Wells Surveying, PLS 54657", in road bank, bears North 19 1/2° West, 43.8 feet.

Attached bearing object signs to all accessories.

LOCATION AND COMMENTS: Corner is located in the centerline of Campbell Road.

OREGON STATE PLANE COORDINATE, North Zone, NAD 83(91), International Feet:

N= 760524.61'

E= 8644858.64'


FIRM: Wells Surveying
P.O. Box 1696
Pendleton, OR 97801

COMPASS DECLINATION: 18° East

Surveyor's Seal

Witnesses: Jason Wells, PLS
Dean Roy

\3N32L21

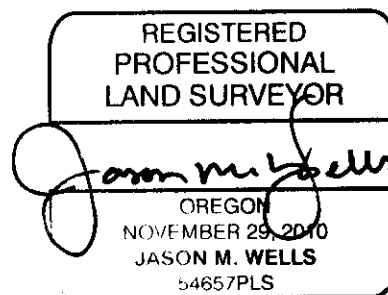

RENEWALS: 6-30-14