

OREGON CORNER RESTORATION FORM

COUNTY: Umatilla DATE: 07/10/13

CORNER DESIGNATION: 3N32, N15, The North One-Quarter Corner of Section 22.

PREVIOUS RENEWALS/SURVEYS ETC.: Corner originally established by David Chaplin, under GLO Contract dated September 1864, notes state: Set post for 1/4 Sec. corner in mound of Earth with charred stake, pits trench &c as per instructions.

MONUMENT AND ACCESSORIES FOUND: None.

MONUMENT MARKING DETAIL:

T3N R32E
1 S15
4 S22
2013
PLS 54657

MONUMENT SET: Reestablished corner at held the intersection of centerline of Fulton Road East-West and County Road 1007 to the South as best evidence of the original corner position and set a 2" aluminum cap on a 5/8" x 24" iron rod, 1" below paved road surface stamped as stated in "Monument Marking Detail", from which:

A 5/8" x 24" iron rod with a purple plastic cap stamped "Wells Surveying, PLS 54657" bears North 62° East, 44.4 feet.

A 5/8" x 24" iron rod with a purple plastic cap stamped "Wells Surveying, PLS 54657" bears South 52 1/2° East, 38.9 feet.

A 5/8" x 24" iron rod with a purple plastic cap stamped "Wells Surveying, PLS 54657" bears South 50° West, 39.9 feet.

A 5/8" x 24" iron rod with a purple plastic cap stamped "Wells Surveying, PLS 54657" bears North 28° West, 105.2 feet.

Attached bearing object tags to rebar.

LOCATION AND COMMENTS:

At centerline of Fulton Road and County Road 1007 to the South.

OREGON STATE PLANE COORDINATE, North Zone, NAD 83(91), International Feet:

N= 757728.58'
E= 8636863.34'


FIRM: Wells Surveying
P.O. Box 1696
Pendleton, OR 97801

COMPASS DECLINATION: 18° East

Surveyor's Seal

Witnesses: Jason Wells, PLS
Dean Roy

\3N32N15

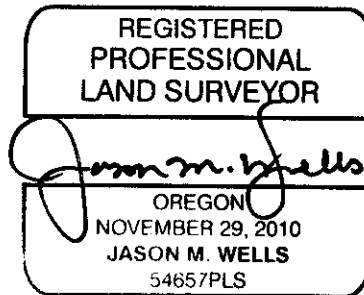

RENEWS: 6-30-14