

**OREGON CORNER RESTORATION FORM**

COUNTY: Umatilla DATE: 07/11/13

CORNER DESIGNATION: 3N32, N07, The North One-Quarter Corner of Section 20.

PREVIOUS RENEWALS/SURVEYS ETC.: Corner originally established by David Chaplin, under GLO Contract dated September 1864, notes state: Set post for 1/4 Sec. corner in mound of Earth with charred stake, pits, trench &c as per instructions. Umatilla County Survey No. 12-126-B, by JUB Engineers, Inc. states: "computed position only, no monument found or set".

MONUMENT AND ACCESSORIES FOUND: None.

MONUMENT MARKING DETAIL:

T3N R32E  
1 S17  
4 S20  
2013  
PLS 54657

MONUMENT SET: Held the position computed on Survey No. 12-126-B. The corner position is based on the visual intersection of Howdyshell Road West and Westersund Road North. I tied into monuments from said Survey No. 12-126-B to located the corner point and set a 2 3/8" brass cap on a 1 1/4" x 30" galvanized iron pipe, with cap 10 inches below ground level for reestablished corner, stamped as stated in "Monument Marking Detail", from which:  
A 5/8" x 24" iron rod with a 1 1/4" purple plastic cap stamped "Wells Surveying, PLS 54657" bears North 87° East, 20.7 feet.  
A 5/8" x 24" iron rod with a 1 1/4" purple plastic cap stamped "Wells Surveying, PLS 54656" bears South 79° West, 22.0 feet.  
A 5/8" x 24" iron rod with a 1 1/4" purple plastic cap stamped "Wells Surveying, PLS 54656" bears South 79° West, 61.7 feet.  
A 5/8" x 24" iron rod with a 1 1/4" purple plastic cap stamped "Wells Surveying, PLS 54656" bears North 78° West, 62.7 feet.  
Attached bearing object signs to all accessories.

LOCATION AND COMMENTS: Located at the visual intersection of Howdyshell Road West and Westersund Road North.

OREGON STATE PLANE COORDINATE, North Zone, NAD 83(91), International Feet:  
N= 757533.21'  
E= 8626289.13'


FIRM: Wells Surveying  
P.O. Box 1696  
Pendleton, OR 97801

COMPASS DECLINATION: 18° East

Surveyor's Seal

Witnesses: Jason Wells, PLS  
Dean Roy

\3N32N07

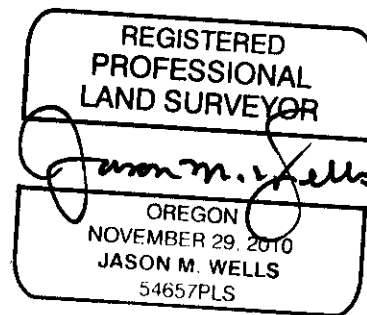

RENEWS: 6-30-14