

**OREGON CORNER RESTORATION FORM**

COUNTY: Umatilla DATE: 07/16/13

CORNER DESIGNATION: 3N32, P13, The West One-Quarter Corner of Section 22.

PREVIOUS RENEWALS/SURVEYS ETC.: Corner originally established by David Chaplin, under GLO Contract dated September 1864, notes state: Set post for 1/4 Sec. corner in mound of Earth with charred stake, pits, trench &c as per instructions. Old State Highway maps generally indicate Highway 37 is built along the section lines.

MONUMENT AND ACCESSORIES FOUND: None.

MONUMENT MARKING DETAIL: Set a railroad spike stamped as indicated below.

MONUMENT SET: Held a line between the Southwest and Northwest corners of Section 22 with its intersection of a old field line extending West as the best remaining evidence of the original corner location. At the reestablished corner position, in the Northbound lane of Highway 37, approximately 5' West of edge of pavement, set a railroad spike stamped "PLS 54687+" 1" below the asphalt surface. From which:

A 3/4" brass washer stamped "PLS 1106" on PP&L pole #220561 bears North 34 1/2° East, 39.9 feet.

A 3/4" brass washer stamped "PLS 1106" on PP&L pole #220460 bears South 06° East, 216.8 feet.

A 5/8" x 24" iron rod with a 1 1/4" purple plastic cap stamped "Wells Surveying, PLS 54657" bears South 26 1/2° West, 48.4 feet.

A 5/8" x 24" iron rod with a 1 1/4" purple plastic cap stamped "Wells Surveying, PLS 54657" bears North 32° West, 39.1 feet.

Attached bearing object tags to all accessories.

LOCATION AND COMMENTS: In northbound lane of Highway 37, approximately 5' West of edge of pavement. A field line extends West.

OREGON STATE PLANE COORDINATE, North Zone, NAD 83(91), International Feet:

N= 755042.24'

E= 8634270.25'

FIRM: Wells Surveying

P.O. Box 1696

Pendleton, OR 97801


COMPASS DECLINATION: 18° East

Surveyor's Seal

Witnesses: Jason Wells, PLS

Dean Roy

\3N32P13

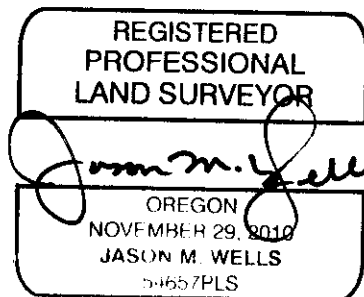

RENEWS: 6-30-14