

OREGON CORNER RESTORATION FORM

Section: 24, 19 Township: 3N Range: 32E, 33E
County: Umatilla Date: 3/9/2011

Corner Designation: 3N33P01 (Amended 3/13/2012)

Quarter corner common to Sections 24, T3NR32E; 19, T3NR33E.

	Condition Report Only
X	Not Found
X	Remonumented
	Unrecorded
X	Surveyed In
X	Referenced Out


Previous Renewals / Surveys, etc.

Originally surveyed by Thompson in 1864. He set an 18" x 10" x 6" stone for the quarter corner.


Monuments and Accessories Found: (Condition and Source):

None.

Diagram

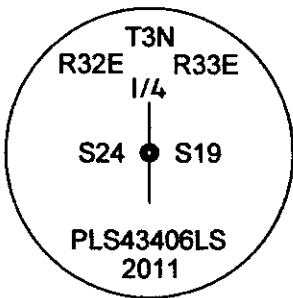

Sketch

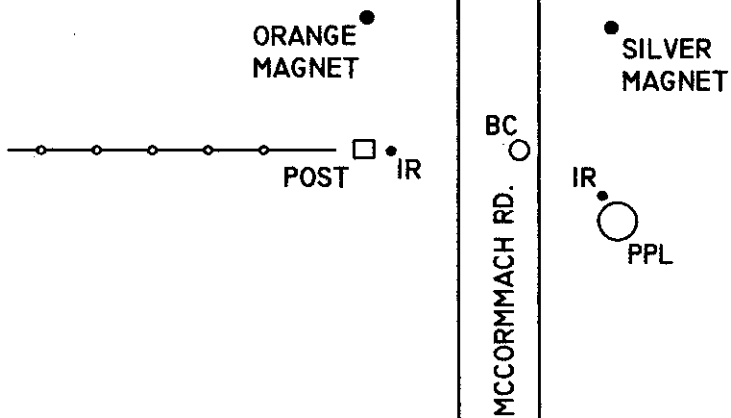

NAD 83/91
OREGON STATE PLANE NORTH
INTERNATIONAL FEET

N755372.37
E8650154.18

Monument(s) Set (Procedures and Description):

A 1 1/8" x 30" galvanized iron pipe with a 2 1/2" brass cap, stamped as shown above, 0.8' below the road surface, at the intersection of Westerly fence line and North-South line held between found corners.

References Set:

- "Deep One" magnets by Berntsen.
- An orange magnet lies N 49° W, 36.78', 1.5' deep.
- A silver magnet lies N 36° 50' E, 26.54', 1.2' deep.
- A 5/8" x 30" iron rebar w/RPC #43406 lies S 65° E, 14.23'.
- A 5/8" x 30" iron rebar w/RPC #43406 lies S 89° W, 27.62'

Location and Comments:

The corner is located 1/2 mile South of the intersection of Fulton Rd. and McCormmach Rd.

Compass Declination

17° E

Surveyors Seal

REGISTERED
PROFESSIONAL
LAND SURVEYOR

Robert D. English
OREGON
JANUARY 11, 2005
ROBERT DOUGLAS ENGLISH
43406LS

RECEIVED BY:

Date: 7/10/2012
Rec'd By: S. Oles
No. 12-094-C

Firm / Agency

Survey One, LLC.
P.O. Box 382
Pendleton, OR 97801
(541) 276-2055

RENEWAL DATE: 12/31/13