

**OREGON CORNER RESTORATION FORM**

Section 19 Township 3N  
County Umatilla Date: 03/14/11

Range 33E

Corner Designation: 3N33P1

1/4 Corner common to sections 19, T3NR33E, and 24, T3NR32E.

_____	Condition Report Only
X_____	Not Found
X_____	Re-monumented
_____	Unrecorded
X_____	Surveyed In
X_____	Referenced Out


**Previous Renewals / Surveys, etc.**

Originally Surveyed by Thompson in 1864. He set a post in a mound of earth.  
Moody set a post in a mound of earth in 1871.


**Monuments and Accessories Found: (Condition and Source)**

None.

**Diagram**

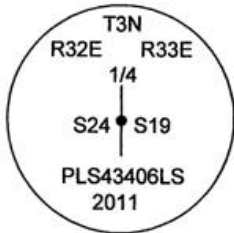

**Sketch**

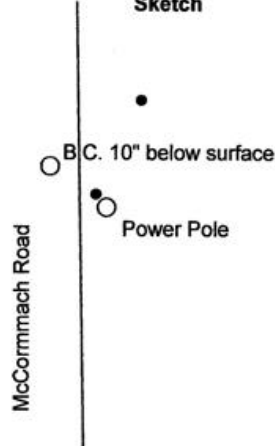

NAD 83/91  
OREGON STATE PLANE NORTH  
INTERNATIONAL FEET

N755372.37  
E8650154.18

**Monument (s) Set (Procedures and Description)**

Set a 1 1/8" x 30" galvanized iron pipe with a 2 1/2" brass cap, stamped as shown below, set at intersection of Westery fence and North-South line between found corners.

**References Set:** "Deep One" magnets by Bermtsen.

- A Silver magnet, 14" deep, lies N 36°50' E, 26.54'.
- A 5/8" x 30" Iron rebar w/rpc #43406 lies S 65° E, 14.23'.
- A 5/8" x 30" Iron rebar w/rpc #43406 lies S 89° W, 27.62'.
- An Orange magnet, 18" deep, lies N 49° W, 36.78'.

**Location and Comments**

The corner is 0.5 miles South of the intersection of Fulton Rd. and McCormmach Rd.

**Compass Declination**

17° E

**Surveyors Seal**

REGISTERED  
PROFESSIONAL  
LAND SURVEYOR

*Robert D. English*  
OREGON  
JANUARY 11, 2005  
ROBERT DOUGLAS ENGLISH  
43406LS

RENEWAL DATE: 12/31/11

**RECEIVED BY:**

\_\_\_\_\_  
Date: \_\_\_\_\_  
Rec'd By: \_\_\_\_\_  
No. \_\_\_\_\_

**Firm / Agency**

Survey One, LLC.  
P.O. Box 382  
Pendleton, OR 97801  
(541) 276-2055