

OREGON CORNER RESTORATION FORM

Section: 19, 20 Township: 3N Range: 33E
County: Umatilla Date: 6/1/2011

Corner Designation: 3N33P05

Quarter corner common to Sections 19, 20, T3NR33E.

| | |
|-------|-----------------------|
| _____ | Condition Report Only |
| X | Not Found |
| X | Remonumented |
| _____ | Unrecorded |
| X | Surveyed In |
| X | Referenced Out |


Previous Renewals / Surveys, etc.

Originally surveyed by Chaplin in 1864. He set a post in a mound of earth.


Monuments and Accessories Found: (Condition and Source):

None.

Diagram

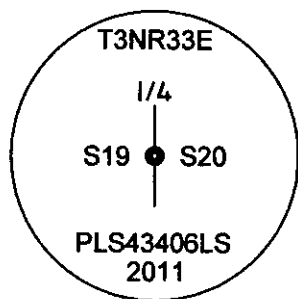

Sketch

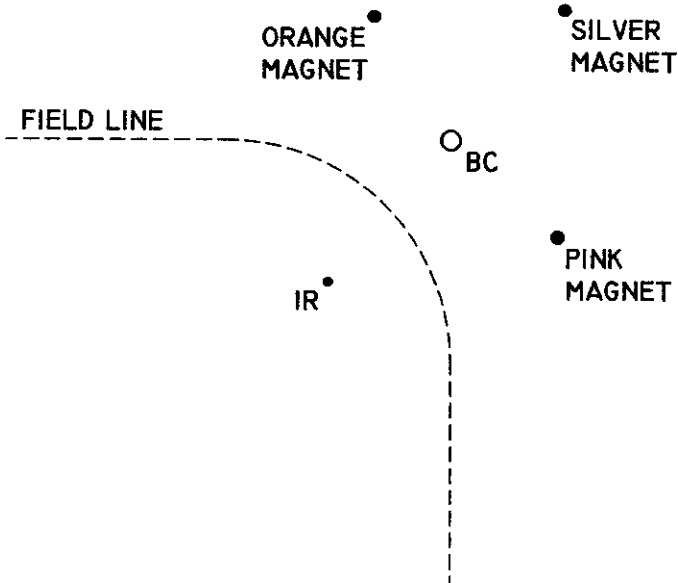

NAD 83/91
OREGON STATE PLANE NORTH
INTERNATIONAL FEET

N755469.50
E8655363.44

Monument(s) Set (Procedures and Description):

A 1 1/8" x 30" galvanized iron pipe with a 2 1/2" brass cap, stamped as shown above, 1.4' below the surface. The corner location was reestablished by single proportionate method between neighboring corners to the North and South.

References Set:

- "Deep One" magnets by Berntsen.
- An orange magnet lies N 31° 30' W, 15.45', 1.3' deep.
- A silver magnet lies N 41° E, 17.85', 1.0' deep.
- A pink magnet lies S 48° 15' E, 15.27', 1.2' deep.
- A 5/8" x 30" iron rebar w/RPC #43406 lies S 41° W, 19.43'.

Location and Comments:

The corner is located 1/2 mile South and 1/2 mile West of the intersection of Fulton Rd. and Myrick Rd.

Compass Declination

17° E

Surveyors Seal

REGISTERED
PROFESSIONAL
LAND SURVEYOR

Robert D. English

OREGON
JANUARY 11, 2005
ROBERT DOUGLAS ENGLISH
43406LS

RENEWAL DATE: 12/31/13

RECEIVED BY:

Firm / Agency

Date: 7/10/2012
Rec'd By: [Signature]
No. 12-094-C

Survey One, LLC.
P.O. Box 382
Pendleton, OR 97801
(541) 276-2055