

OREGON CORNER RESTORATION FORM

Section: 24, 25, 19, 30
County: Umatilla

Township: 3N
Date: 3/9/2011

Range: 32E, 33E

Corner Designation: 3N33R01 (Amended 3/19/2012)

Section corner common to Sections 24, 25, T3NR32E; 19, 30, T3NR33E.

	Condition Report Only
X	Not Found
X	Remonumented
	Unrecorded
X	Surveyed In
X	Referenced Out


Previous Renewals / Surveys, etc.

Originally surveyed by Thompson in 1864. He set a post in a mound of earth. The N. P. Ry. "Wallula to Pendleton" Right of Way Plat, Umatilla County Railroad Map #120, shows the corner at 1,065.2' South of the track centerline and 730.5' West of the track centerline. Map #128 also shows the corner at 730.5' West of the track centerline.


Monuments and Accessories Found: (Condition and Source):

None.

Diagram

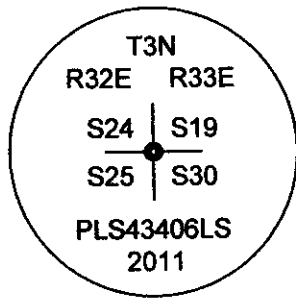

Sketch

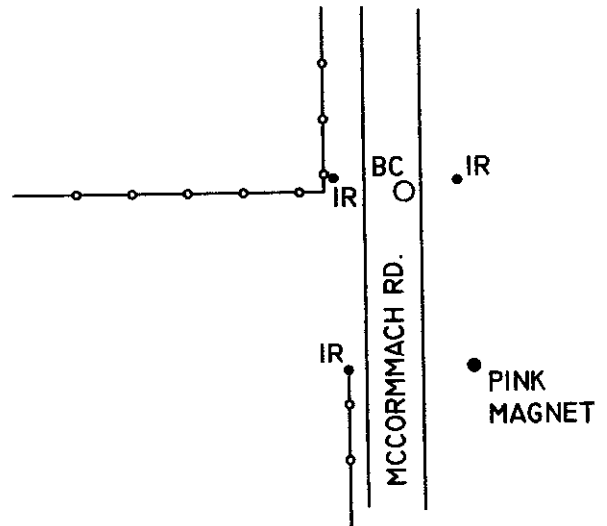

NAD 83/91
OREGON STATE PLANE NORTH
INTERNATIONAL FEET

N752727.59
E8650211.44

Monument(s) Set (Procedures and Description):

A 1 1/8" x 30" galvanized iron pipe with a 2 1/2" brass cap, stamped as shown above, 1.6' below surface, at the intersection of the North-South line held between monuments and the old fence line to the West.

References Set:

- "Deep One" magnet by Berntsen.
- A 5/8" x 30" iron rebar w/RPC #43406 lies N 74° 40' W, 26.29'.
- A 5/8" x 30" iron rebar w/RPC #43406 lies N 78° 10' E, 7.61'.
- A pink magnet lies S 20° 30' E, 42.66', 1.4' deep.
- A 5/8" x 30" iron rebar w/RPC #43406 lies S 18° 10' W, 64.25'.

Location and Comments:

The corner is located 1 mile South of the intersection of Fulton Rd. and McCormach Rd.

Compass Declination
17° E

Surveyors Seal

REGISTERED
PROFESSIONAL
LAND SURVEYOR

Robert D. English
OREGON
JANUARY 11, 2005
ROBERT DOUGLAS ENGLISH
43406LS

RENEWAL DATE: 12/31/13

RECEIVED BY:

Date: 7/10/2012
Rec'd By: [Signature]
No. 12-094-C

Firm / Agency

Survey One, LLC.
P.O. Box 382
Pendleton, OR 97801
(541) 276-2055