

**OREGON CORNER RESTORATION FORM**

Section: 22, 27      Township: 3N      Range: 33E  
County: Umatilla      Date: 3/20/2012

Corner Designation: 3N33R15

Quarter corner common to Sections 22, 27, T3NR33E.

_____	Condition Report Only
<u>  X  </u>	Not Found
<u>  X  </u>	Remonumented
_____	Unrecorded
<u>  X  </u>	Surveyed In
<u>  X  </u>	Referenced Out


**Previous Renewals / Surveys, etc.**

Originally surveyed by Chaplin in 1864. He set a 20" x 8" x 6" stone.  
In 1871 Moody set a 17" x 14" x 9" stone.  
In 1887 Currin and Noland set a 10" x 8" x 6" basalt stone in a mound of earth and dug pits to the East and West.


**Monuments and Accessories Found: (Condition and Source):**

None.

**Diagram**

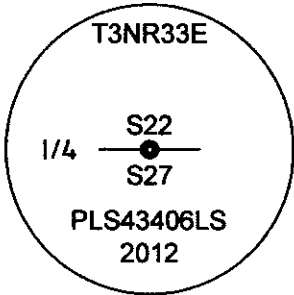

**Sketch**

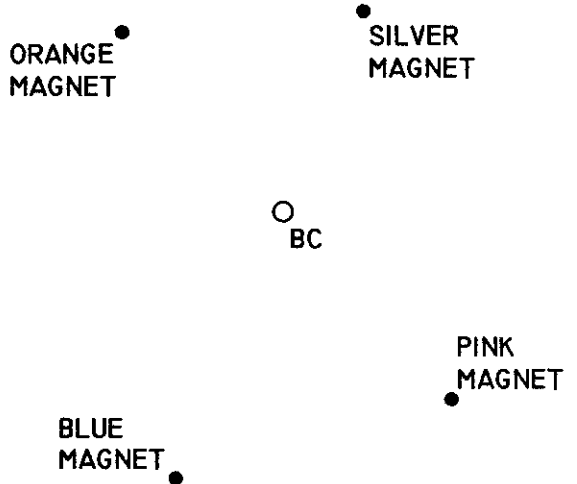

NAD 83/91  
OREGON STATE PLANE NORTH  
INTERNATIONAL FEET

N753116.07  
E8668674.27

**Monument(s) Set (Procedures and Description):**

A 1 1/8" x 30" galvanized iron pipe with 2 1/2" brass cap, stamped as shown above, 1.6' below the surface. No apparent evidence survived, as the corner lies in an active wheat field which has been terraced. The corner location was reestablished by single proportionate method between neighboring corners to the East and West.

**References Set:**

"Deep One" magnets by Berntsen.  
An orange magnet lies N 42° W, 24.94', 1.6' deep.  
A silver magnet lies N 23° 10' E, 22.36', 1.7' deep.  
A pink magnet lies S 41° 30' E, 26.24', 1.8' deep.  
A blue magnet lies S 22° 50' W, 29.93', 1.7' deep.

**Location and Comments:**

The corner is located 1 mile North and 1/2 mile East of the intersection of Hwy. 11 and South Market Rd.

**Compass Declination**

17° E

**Surveyors Seal**

REGISTERED  
PROFESSIONAL  
LAND SURVEYOR

*Robert D. English*  
OREGON  
JANUARY 11, 2005  
ROBERT DOUGLAS ENGLISH  
43406LS

RENEWAL DATE: 12/31/13

**RECEIVED BY:**

Date: 7/10/2012  
Rec'd By: S. Jones  
No. 12-094-C

**Firm / Agency**

Survey One, LLC.  
P.O. Box 382  
Pendleton, OR 97801  
(541) 276-2055