

OREGON CORNER RESTORATION FORM

R19-12-63C

COUNTY: Umatilla

DATE: May 3, 2012

CORNER DESIGNATION: R-19 South 1/4 Corner Section 23, T. 3 North, Range 33 E.W.M.

PREVIOUS RENEWALS/SURVEYS ETC.

Daniel Chaplain, under Contract No. 107, dated September 21, 1864, set post in mound of earth with charred stake and pits  
Zenas Moody, under Contract No. 164, dated October 4, 1871, set post and made earth mound

James Currin and James Noland, under special joint contract, dated May 4, 1887, set stone, dug pits, and raised mound of earth

Robert English, PLS 43406, under contract with Umatilla County, set a 2-3/8" brass cap in April, 2012

MONUMENT AND ACCESSORIES FOUND:


Found English's brass cap

MONUMENT SET:

After reviewing highway right-of-way maps and county road notes, and discussions with Bob English, it was determined that the 1/4 corner should be moved west to better fit the center of the Havana-Helix Highway. It was agreed that his brass cap would become a reference monument. Set a mag nail with brass washer marked "LS2627" at the revised corner location and stamped the brass cap with an arrow pointing to the corner and add the letters "RM" and the distance "25.24"

MONUMENT MARKING DETAIL:

SKETCH: NOT TO SCALE

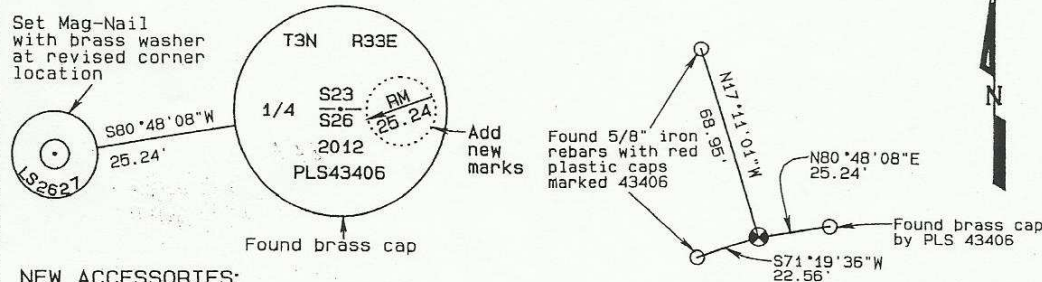

NEW ACCESSORIES:

English's brass cap becomes an accessory. It bears N80°48'08"E, 25.24' from corner point.

A 5/8" iron rebar with 1-1/4" red plastic cap marked "43406) bears N17°11'01"W, 68.95' from corner point.

A 5/8" iron rebar with 1-1/4" red plastic cap marked "43406) bears S71°19'36"W, 22.56' from corner point.

No other accessories set by English were tied. His corner form with state plane coordinates and ties to other accessories will be filed at a later date.

LOCATION AND COMMENTS:

Corner is located in the center of the Havana-Helix Highway approximately 300 feet north of its intersection with Highway 11.

COMPASS DECLINATION:

N/A

FIRM/AGENCY:

Umatilla County Road Department  
3920 Westgate  
Pendleton, Oregon 97801

PARTY CHIEF:

Matthew Kenny, LSIT

NOTES:

N/A

WITNESS:

N/A

SURVEYOR'S SEAL

REGISTERED PROFESSIONAL LAND SURVEYOR

*Day H. Roberts*  
OREGON  
JULY 20, 1993  
GARY R. ROBERTS  
2627

RECEIVED BY

Umatilla County Surveyor

Date: 5/8/2012

Rec'd By: *A. Res*

No.: 12-063-C

RENEWS 12/31/2012