

OREGON CORNER RESTORATION FORM

Section: 24, 25 Township: 3N Range: 33E
County: Umatilla Date: 1/18/2012

Corner Designation: 3N33R23

Quarter corner common to Sections 24, 25, T3NR33E.

| | |
|---|-----------------------|
| | Condition Report Only |
| X | Not Found |
| X | Remonumented |
| | Unrecorded |
| X | Surveyed In |
| X | Referenced Out |


Previous Renewals / Surveys, etc.

Originally surveyed by Chaplin in 1864. He set a post in a mound of earth, with charred stake and pits.
In 1871 Moody set a post in a mound of earth.
In 1887 Currin and Noland set a post in a mound of earth, with pits to the East and West.


Monuments and Accessories Found: (Condition and Source):

None.

Diagram

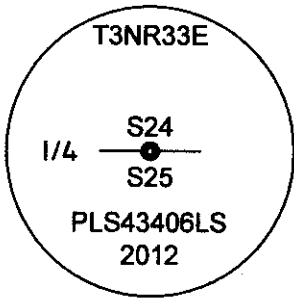

Sketch

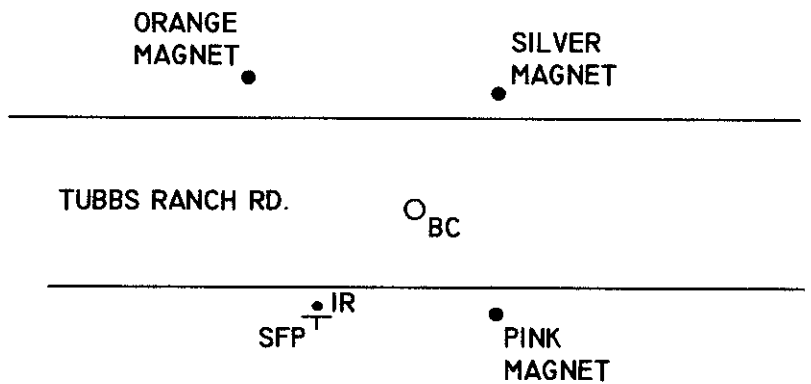

NAD 83/91
OREGON STATE PLANE NORTH
INTERNATIONAL FEET

N753305.13
E8679218.68

Monument(s) Set (Procedures and Description):

A 1 1/8" x 30" galvanized iron pipe with 2 1/2" brass cap, stamped as shown above.
The corner location was reestablished by single proportionate method between neighboring corners to the East and West.

References Set:

- "Deep One" magnets by Berntsen.
- An orange magnet lies N 51° W, 44.28', 1.6' deep.
- A silver magnet lies N 36° 40' E, 29.80', 1.6' deep.
- A pink magnet lies S 36° 50' E, 27.65', 1.6' deep.
- A 5/8" x 30" iron rebar w/RPC #43406 lies S 46° W, 28.40', at a steel fence post.

Location and Comments:

The corner is located 0.9 miles East of the intersection of Hwy. 11 and Tubbs Ranch Rd.

Compass Declination

17° E

Surveyors Seal

REGISTERED
PROFESSIONAL
LAND SURVEYOR

Robert Douglas English
OREGON
JANUARY 11, 2005
ROBERT DOUGLAS ENGLISH
43406LS

RECEIVED BY:

Firm / Agency

Date: 7/10/2012
Rec'd By: S. Des
No. 12-094-C

Survey One, LLC.
P.O. Box 382
Pendleton, OR 97801
(541) 276-2055

RENEWAL DATE: 12/31/13