

**OREGON CORNER RESTORATION FORM**

Section: 24, 25, 19, 30 Township: 3N Range: 33E, 34E  
County: Umatilla Date: 1/11/2012

Corner Designation: 3N33R25

Section corner common to Sections 24, 25, T3NR33E; 19, 30, T3NR34E.

_____	Condition Report Only
_____	Not Found
_____ X _____	Remonumented
_____	Unrecorded
_____	Surveyed In
_____ X _____	Referenced Out


**Previous Renewals / Surveys, etc.**

Originally surveyed by Thompson in 1864. He set a post in a mound of earth with charred stake, pits, and a trench. In 1871 Moody set a post in a mound of earth. In 1910 J. Kimbrell found the corner in Private Survey No. 322, as recorded in Book 2, pg. 179. Krumbein found a 1/2" spike in Survey I-150-B.


**Monuments and Accessories Found: (Condition and Source):**

Found 60D spike under asphalt concrete.

**Diagram**

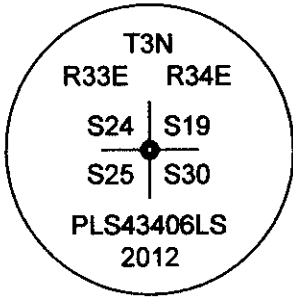

**Sketch**

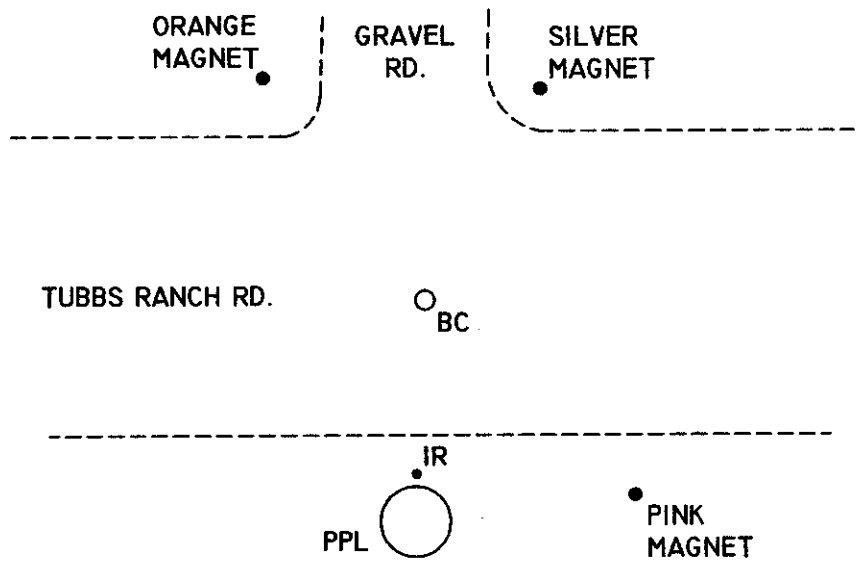

NAD 83/91  
OREGON STATE PLANE NORTH  
INTERNATIONAL FEET  
  
N753384.25  
E8681833.62

**Monument(s) Set (Procedures and Description):**

A 1 1/8" x 30" galvanized iron pipe with 2 1/2" brass cap, stamped as shown above, 0.6' below the surface of an oil mat road.

**References Set:**

- "Deep One" magnets by Berntsen.
- An orange magnet lies N 35° 40' W, 28.72', 1.5' deep.
- A silver magnet lies N 30° E, 25.03', 1.6' deep.
- A pink magnet lies S 46° 20' E, 30.08', 1.6' deep.
- A 5/8" x 30" iron rebar w/RPC #43406 lies S 4° W, 19.79', at a power pole.

**Location and Comments:**

The corner lies 1.4 miles East of the intersection of Hwy. 11 and Tubbs Ranch Rd.

**Compass Declination**

17° E

**Surveyors Seal**

REGISTERED  
PROFESSIONAL  
LAND SURVEYOR

*Robert D. English*

OREGON  
JANUARY 11, 2005  
ROBERT DOUGLAS ENGLISH  
43406LS

RENEWAL DATE: 12/31/13

**RECEIVED BY:**

Date: 7/10/2012  
Rec'd By: J. Gles  
No. 12-094-C

**Firm / Agency**

Survey One, LLC.  
P.O. Box 382  
Pendleton, OR 97801  
(541) 276-2055