

OREGON CORNER RESTORATION FORM

Section: 25, 30
County: Umatilla

Township: 3N
Date: 1/10/2012

Range: 33E, 34E

Corner Designation: 3N33T25

Quarter corner common to Sections 25, T3NR33E; 30, T3NR34E.

_____	Condition Report Only
_____X_____	Not Found
_____X_____	Remonumented
_____	Unrecorded
_____X_____	Surveyed In
_____X_____	Referenced Out


Previous Renewals / Surveys, etc.

Originally surveyed by Thompson in 1864. He set a post in a mound of earth, with charred stake, pits, and a trench. In 1871 Moody set a post in a mound of earth.


Monuments and Accessories Found: (Condition and Source):

None.

Diagram

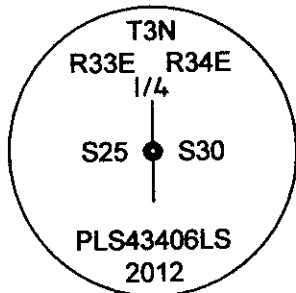

Sketch

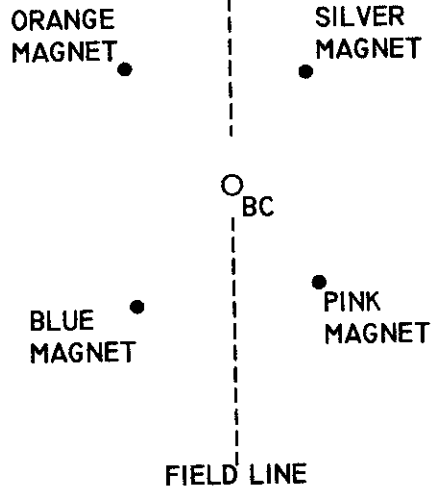

NAD 83/91
OREGON STATE PLANE NORTH
INTERNATIONAL FEET

N750725.10
E8681895.07

Monument(s) Set (Procedures and Description):

A 1 1/8" x 30" galvanized iron pipe with 2 1/2" brass cap, stamped as shown above, 1.4' below the surface. The corner location was reestablished by single proportionate method between neighboring corners to the North and South.

References Set:

- "Deep One" magnets by Berntsen.
- An orange magnet lies N 40° 45' W, 31.65', 1.5' deep.
- A silver magnet lies N 34° 20' E, 28.07', 1.6' deep.
- A pink magnet lies S 40° 20' E, 27.15', 1.5' deep.
- A blue magnet lies S 39° 20' W, 31.87', 1.5' deep.

Location and Comments:

The corner is located 1/2 mile North and 1 mile West of the intersection of Duff Rd. and Rothrock Rd.

Compass Declination

17° E

Surveyors Seal

REGISTERED
PROFESSIONAL
LAND SURVEYOR

Robert D. English
OREGON
JANUARY 11, 2005
ROBERT DOUGLAS ENGLISH
43406LS

RECEIVED BY:

Date: 7/10/2012
Rec'd By: S. Oles
No. 12-094-C

Firm / Agency

Survey One, LLC.
P.O. Box 382
Pendleton, OR 97801
(541) 276-2055

RENEWAL DATE: 12/31/13