

OREGON CORNER RESTORATION FORM

Section 29,30 Township 3N
County Umatilla Date: 03/17/11

Range 33E

Corner Designation: 3N33T5

1/4 Corner common to sections 29,30 T3NR33E

Condition Report Only
 Not Found
 Remonumented
 Unrecorded
 Surveyed In
 Referenced Out

Previous Renewals / Surveys, etc.

Originally Surveyed by Chaplin, set a post in a mound of earth in 1864.


Monuments and Accessories Found: (Condition and Source)

None.

Diagram



Sketch

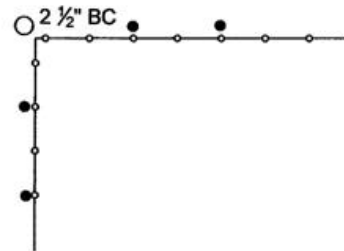

NAD 83/91
OREGON STATE PLANE NORTH
INTERNATIONAL FEET

N750138.34
E8655514.98

Monument (s) Set (Procedures and Description)

Set a 1 1/8" x 30" galvanized Iron pipe with a 2 1/2" Brass cap, stamped as shown above.
Set by single proportion between found monuments North and South one half mile.

References Set:

- A 5/8" x 30" Iron rebar w/rpc# 43406 lies S 1°10' E, 22.94'.
- A 5/8" x 30" Iron rebar w/rpc# 43406 lies S 0°40' E, 10.24'.
- A 5/8" x 30" Iron rebar w/rpc# 43406 lies S 88°30' E, 11.42'.
- A 5/8" x 30" Iron rebar w/rpc #43406 lies N 89°20' E, 32.29'.

Location and Comments

The corner is 1.5 miles South of the intersection of Hwy. 320 and Whitehouse Road, then East on a gravel road 1.0 mile.

Compass Declination

17° E

Surveyors Seal

REGISTERED
PROFESSIONAL
LAND SURVEYOR

Robert D. English
OREGON
JANUARY 11, 2005
ROBERT DOUGLAS ENGLISH
43406LS

RECEIVED BY:

Date: _____
Rec'd By: _____
No. _____

Firm / Agency

Survey One, LLC.
P.O. Box 382
Pendleton, OR 97801
(541) 276-2055

RENEWAL DATE: 12/31/11