

OREGON CORNER RESTORATION FORM

Section 31 Township 3N Range 33E
 County Umatilla Date: May 5, 2001

Corner Designation: 3N33V3

Condition Report Only
 Not found
 Remonumented
 Unrecorded
 Surveyed in
 Referenced out

Quarter corner to sections 30 and 31, T3N, R33E,
 W.M., Umatilla County, Oregon.


Previous Renewals / Surveys, etc.

Corner originally set by Daniel Chaplin under contract No. 107 dated September 21, 1864.
 His record reads: Set post for 1/4 sec. cor. in a mound of earth with charred stake, pits &c as per instructions. John Kimbrell reports that the settlers claimed to have replaced this monument with the corner post of a 4 way fence intersection.


Monument and Accessories found: (condition and source)

A north - south fence with very old wire. There is a fence running east and a plow berm running west which do not line up by 30 feet M/L. The plow berm was moved during the course of this survey.

DIAGRAM

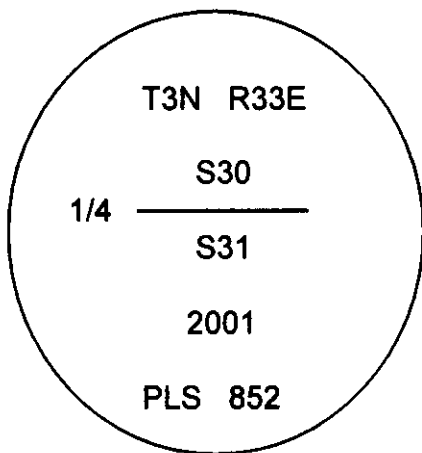

SKETCH

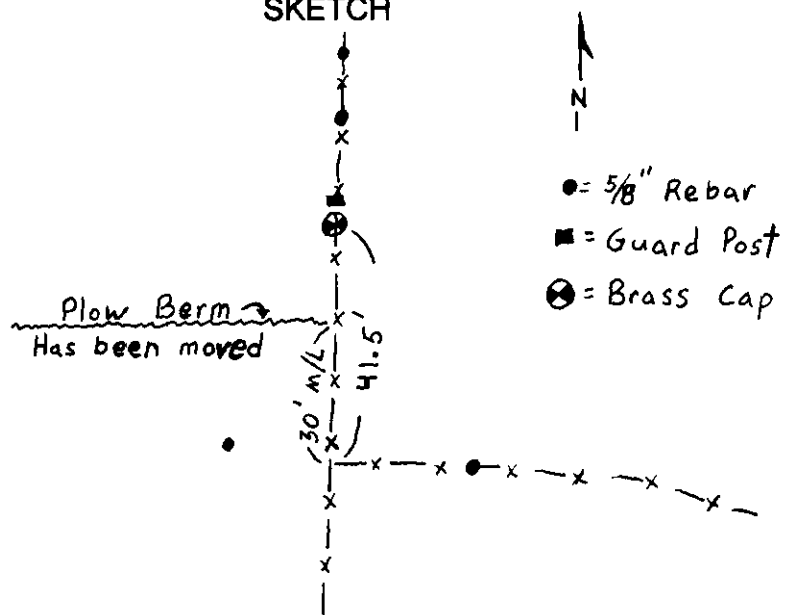

MONUMENT (S) AND ACCESSORIES SET (Procedures and Description)

I set a 2 1/2" brass cap on a 1 1/4" x 30" galvanized iron pipe stamped as shown in the diagram above at the intersection of the north - south fence and the north line of section 31. Set a 6 foot steel fence post with a county monument sign attached along side. Set a clear, Deep 1, magnetic marker at the corner point below the brass cap. This position is south of the other section lines to the east and agrees with Kimbrell's record for distance from these lines.

For references, I set four 5/8" by 24" rebars with 1 1/8" red plastic caps stamped ORLS 852, WALS 13922 as described below:

- an iron rebar bears N00°11'24"W, 49.11 feet 1 foot below the surface under the fence;
- an iron rebar bears N00°24'14"W, 26.66 feet 1 foot below the surface under the fence;
- an iron rebar bears S40°45'47"E, 56.15 feet 18 inches below the surface under the fence;
- an iron rebar bears S38°01'44"W, 47.89 feet 2 feet below the surface in a plowed field;

The monument and references were tied using a LIECA SYSTEM 300 RTK GPS.

Location and comments

Compass Declination

Surveyors Seal

RECEIVED BY:
Umatilla County Surveyor
 Date: 6-01
 Rec'd By: KK
 No. 01-81-C

Firm / Agency
 Haddock Surveying
 Address
 P.O. Box 1574
 Pendleton, Or. 97801
 Party Chief
 Stephen K, Haddock

**REGISTERED
 PROFESSIONAL
 LAND SURVEYOR**

David L. Haddock

**OREGON
 JULY 12, 1988
 DAVID L. HADDOCK
 852**