

OREGON CORNER RESTORATION FORM

Section: 30, 31
County: Umatilla

Township: 3N
Date: 9/29/2011

Range: 33E

Corner Designation: 3N33V03

Quarter corner common to Sections 30, 31, T3NR33E.

- Condition Report Only
- Not Found
- Remonumented
- Unrecorded
- Surveyed In
- Referenced Out


Previous Renewals / Surveys, etc.

Originally surveyed by Chaplin in 1864. He set a post in a mound of earth.
In 1904 J. Kimbrell accepted a four way fence intersection, which settlers claimed to have placed on the point of the original monument, in Private Survey No. 180 as recorded in Book No. 1, pp. 526, 527.
In 2001 D. Haddock set a 1 1/4" x 30" galvanized iron pipe with a 2 1/2" brass cap.

Monuments and Accessories Found: (Condition and Source):

- A 2 1/2" brass cap, stamped as shown below, flush with the surface.
- A 5/8" iron rebar w/RPC #852 lies N 0° 11' 24" W, 49.11', 1.0' deep.
- A 5/8" iron rebar w/RPC #852 lies N 0° 24' 14" W, 26.66', 1.0' deep.
- A 5/8" iron rebar w/RPC #852 lies S 40° 45' 47" E, 56.15', 1.5' deep.
- A 5/8" iron rebar w/RPC #852 lies S 38° 01' 44" W, 47.89', 2.0' deep.


Diagram

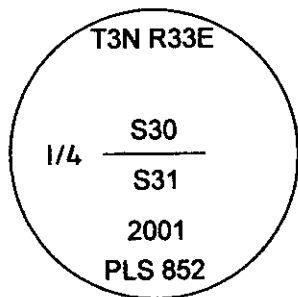

NAD 83/91
OREGON STATE PLANE NORTH
INTERNATIONAL FEET

N747484.18
E8652963.43

Sketch

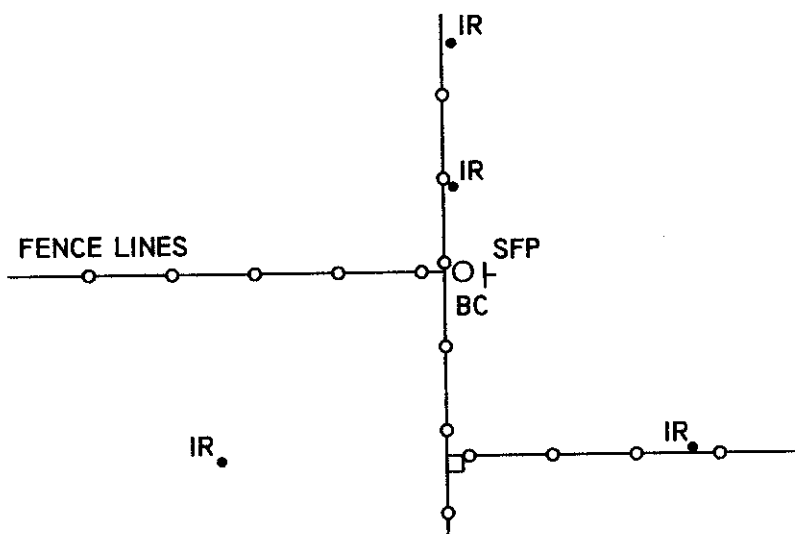

Monument(s) Set (Procedures and Description):

None.

References Set:

None.

Location and Comments:

The corner is located 2 miles South and 1/2 mile East of the intersection of Fulton Rd. and McCormach Rd.

Compass Declination

17° E

Surveyors Seal

REGISTERED
PROFESSIONAL
LAND SURVEYOR

Robert D. English

OREGON
JANUARY 11, 2005
ROBERT DOUGLAS ENGLISH
43406LS

RENEWAL DATE: 12/31/13

RECEIVED BY:

Date: 7/10/2012
Rec'd By: S. Oles
No. 12-094-C

Firm / Agency

Survey One, LLC.
P.O. Box 382
Pendleton, OR 97801
(541) 276-2055