

OREGON CORNER RESTORATION FORM

Section: 29, 30, 31, 32 Township: 3N Range: 33E
County: Umatilla Date: 9/29/2011

Corner Designation: 3N33V05

Section corner common to Sections 29, 30, 31, 32, T3NR33E.

- Condition Report Only
- Not Found
- Remonumented
- Unrecorded
- Surveyed In
- Referenced Out


Previous Renewals / Surveys, etc.

Originally surveyed by Chaplin in 1864. He set a post in a mound of earth.
 In 1871 Moody did not resurvey the corner, as it was within the boundaries of the Umatilla Reservation at the time.
 In 1887 Currin and Noland accepted a decayed post.
 In 1887 Currin and Noland accepted a 20" x 10" x 8" stone said to have been placed by settlers at the exact point of the old corner post.
 In 1904 J. Kimbrell set an 18" x 12" x 8" stone in a mound of stone in Private Survey No. 193 as recorded in Book No. 1, pp. 542, 543.
 The N. P. Ry. "Wallula to Pendleton" Right of Way Plat, Umatilla County Railroad Map #127 and Map #128 both show the corner at 1,670.8' South of the track centerline. Map #129 and Map #130 both show the corner at 616.9' North of the track centerline.
 In 2001 D. Haddock recovered a stone in a mound of stone and set a 1 1/2" x 30" galvanized iron pipe with a 2 1/4" brass cap in a mound of stone with a steel fence post and monument sign as recorded in Survey 01-81-C.


Monuments and Accessories Found: (Condition and Source):

A 2 1/2" brass cap, stamped as shown below, 5" above the surface of a stone mound, with a steel fence post 1.4' to the East.
 A 5/8" iron rebar w/RPC #852 lies N 43° 24' 26" W, 29.09'.
 A 5/8" iron rebar w/RPC #852 lies N 60° 56' 05" E, 21.64'.
 A 5/8" iron rebar w/RPC #852 lies S 60° 31' 57" W, 32.34'.
 A 5/8" iron rebar w/RPC #852 lies S 44° 12' 12" E, 32.32'.

Diagram

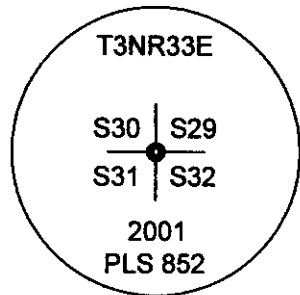

Sketch

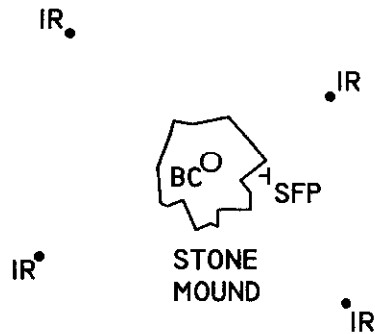

NAD 83/91
OREGON STATE PLANE NORTH
INTERNATIONAL FEET

N747510.84
E8655581.88

Monument(s) Set (Procedures and Description):

Replace witness post sign.

References Set:

None.

Location and Comments:

The corner is located 1/4 mile, M/L, South and 2/3 mile, M/L, West of the intersection of Adams Rd. and Myrick Rd.

Compass Declination

17° E

Surveyors Seal

REGISTERED
PROFESSIONAL
LAND SURVEYOR

Robert D. English
 OREGON
 JANUARY 11, 2005
 ROBERT DOUGLAS ENGLISH
 43406LS

RENEWAL DATE: 12/31/13

RECEIVED BY:

Date: 7/10/2012
 Rec'd By: D. Pres
 No. 12-094-C

Firm / Agency

Survey One, LLC.
 P.O. Box 382
 Pendleton, OR 97801
 (541) 276-2055