

OREGON CORNER RESTORATION FORM

Section: 28, 29, 32, 33 Township: 3N Range: 33E
County: Umatilla Date: 8/30/2011

Corner Designation: 3N33V09

Section corner common to Sections 28, 29, 32, 33, T3NR33E.

<u> </u>	X	Condition Report Only
<u> </u>		Not Found
<u> </u>		Remonumented
<u> </u>		Unrecorded
<u> </u>		Surveyed In
<u> </u>	X	Referenced Out


Previous Renewals / Surveys, etc.

Originally surveyed by Chaplin in 1864. He set a 22" x 8" x 8" stone.
In 1871 Moody set a 17" x 10" x 9" stone.
In May, 1887 Currin and Noland found a 15" x 10" x 3" stone and set a post alongside the stone.
In October, 1887 Currin and Noland set a post in a mound of earth and dug pits.
In 1992 Harris found a fence crib on a very old plow line.

Monuments and Accessories Found: (Condition and Source):


A 2 1/2" brass cap, stamped as shown below, 4" above the surface.

Diagram

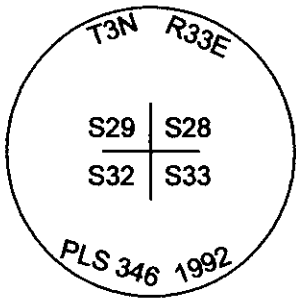

ORANGE
MAGNET

Sketch

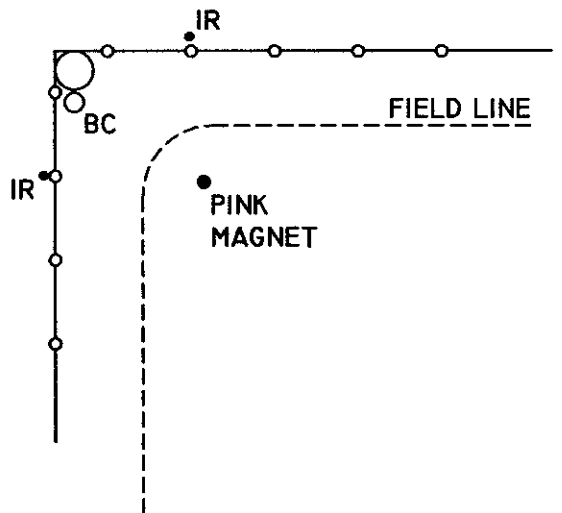

NAD 83/91
OREGON STATE PLANE NORTH
INTERNATIONAL FEET

N747654.41
E8660840.29

Monument(s) Set (Procedures and Description):

None.

References Set:

"Deep One" magnets by Bermtsen.
An orange magnet lies N 72° 50' W, 20.77', 1.4' deep.
A 5/8" x 30" iron rebar w/RPC #43406 lies N 87° 30' E, 27.69'.
A pink magnet lies S 64° E, 41.14', 1.5' deep.
A 5/8" x 30" iron rebar w/RPC #43406 lies S 1° 30' W, 20.03'.

Location and Comments:

The corner is located 1/2 mile South and 1 mile West of the intersection of Hwy. 11 and South Market Rd.

Compass Declination

17° E

Surveyors Seal

REGISTERED
PROFESSIONAL
LAND SURVEYOR

Robert D. English
OREGON
JANUARY 11, 2005
ROBERT DOUGLAS ENGLISH
43406LS

RENEWAL DATE: 12/31/13

RECEIVED BY:

Date: 7/10/2012
Rec'd By: [Signature]
No. 12-094-C

Firm / Agency

Survey One, LLC.
P.O. Box 382
Pendleton, OR 97801
(541) 276-2055