

OREGON CORNER RESTORATION FORM

Section 28 Township 3 N Range 33 E

County Umatilla Date 3-13-92

V-9

CORNER DESIGNATION

Southwest Corner Section 28

- Condition Report Only
- Not Found
- Renewed
- Unrecorded
- Surveyed In
- Referenced Out

Previous Renewals/Surveys, etc. _____

May 4, 1887



By Currin & Noland

Monument(s) & Accessories Found: (Condition and Source)

Fence crib - very old plow line

Monument Detail

Sketch

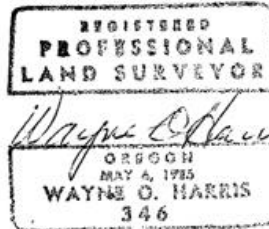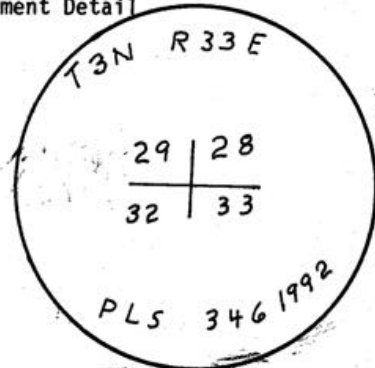

Monument Set (Procedures and Description)

2 1/2 inch Brass Cap on 30 inch pipe - line surveyed -
checked against original Field notes

Buried 24 inch in ground - protrude 6 inches

New Accessories

Witness Corner - plastic cap on 30 inch 3/4 inch iron pipe
set 25 feet North in fence line

Witness Corner - plastic cap on 30 inch 3/4 inch iron pipe
set 25 feet West in fence line

Location & Comments

Surveyor's Seal

Compass Declination _____

Firm/Agency Wayne Harris Co., Inc.

RECEIVED BY

Umatilla County Surveyor

Date 5-92

Rec'd By KK

No. 92-63-B

Address P.O. Box 566

Pendleton, Oregon 97801

Party Chief Wayne O. Harris

Notes _____

Witness F. S. Munro

RECEIVED BY

Umatilla County Surveyor

Date _____

Rec'd By _____

No. _____