

OREGON CORNER RESTORATION FORM

Section: 36, 31 Township: 3N Range: 33E, 34E
County: Umatilla Date: 11/1/2011

Corner Designation: 3N33W25

North Sixteenth corner common to Sections 36, T3NR33E; 31, T3NR34E.

Condition Report Only
 Not Found
 Remonumented
 Unrecorded
 Surveyed In
 Referenced Out


Previous Renewals / Surveys, etc.

Originally surveyed by Krumbain in 1971. He set a 1 1/2" iron pipe with 2 1/2" brass cap in Survey 03-295-B. Caps set in this survey were old stock originally intended to be used to mark allotment corners.

Monuments and Accessories Found: (Condition and Source):

A 2 1/2" brass cap, stamped as shown below, 10" below the surface. Date on brass cap appears to have been stamped over. Monument is rotated 90° to the left.


Diagram

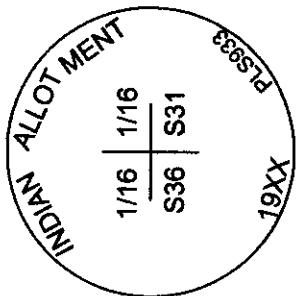

ORANGE
MAGNET

BLUE
MAGNET

Sketch

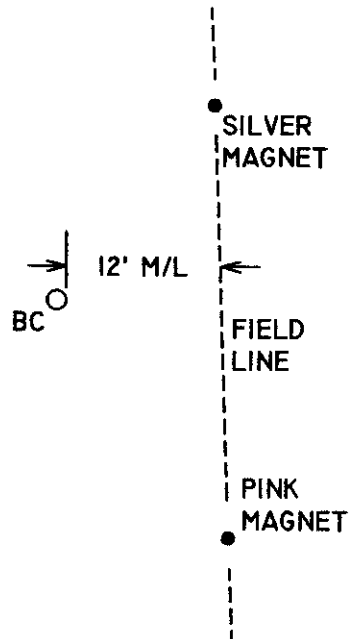

NAD 83/91
OREGON STATE PLANE NORTH
INTERNATIONAL FEET

N746736.72
E8681987.47

Monument(s) Set (Procedures and Description):

References Set:

"Deep One" magnets by Berntsen.
An orange magnet lies N 39° 30' W, 24.19', 1.5' deep.
A silver magnet lies N 39° 40' E, 25.75', 1.6' deep.
A pink magnet lies S 34° 40' E, 30.72', 1.6' deep.
A blue magnet lies S 33° 50' W, 29.30', 1.6' deep.

Location and Comments:

The corner is located 1/4 mile South and 1 mile West of the intersection of Duff Rd. and Rothrock Rd.

Compass Declination

17° E

Surveyors Seal

REGISTERED
PROFESSIONAL
LAND SURVEYOR

Robert D. English
OREGON
JANUARY 11, 2005
ROBERT DOUGLAS ENGLISH
43406LS

RENEWAL DATE: 12/31/13

RECEIVED BY:

Date: 7/10/2012
Rec'd By: S. Oles
No. 12-094-C

Firm / Agency

Survey One, LLC.
P.O. Box 382
Pendleton, OR 97801
(541) 276-2055