

**OREGON CORNER RESTORATION FORM**

Section: 33 Township: 3N Range: 33E  
County: Umatilla Date: 4/19/2012

Corner Designation: 3N33Z11

South quarter corner of Section 33 only.

_____	Condition Report Only
<u>  X  </u>	Not Found
<u>  X  </u>	Remonumented
_____	Unrecorded
<u>  X  </u>	Surveyed In
<u>  X  </u>	Referenced Out


**Previous Renewals / Surveys, etc.**

Originally surveyed by Thompson in 1864. He set a post in a mound of earth, with charred stake, pits, and a trench.  
In 1871 Moody set a post in a mound of earth.  
In 1887 Currin and Noland set a basalt stone 15" x 7" x 6", dug pits to the East and West, and raised a mound of earth.  
In 1887 Currin and Noland found a 15" x 7" x 6" stone.  
In 1902 MaComber set a 6" x 8" x 15" stone in Private Survey No. 135, as recorded in Book 1, pp. 458-459.


**Monuments and Accessories Found: (Condition and Source):**

None.

**Diagram**

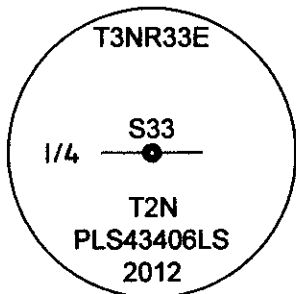

**Sketch**

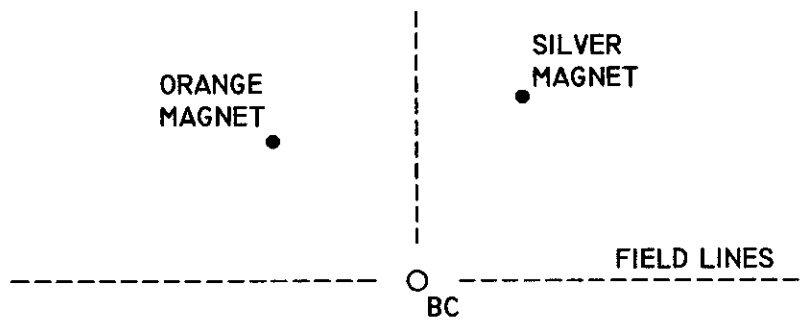

NAD 83/91  
OREGON STATE PLANE NORTH  
INTERNATIONAL FEET

N742380.89  
E8663623.08

**Monument(s) Set (Procedures and Description):**

A 1 1/8" x 30" galvanized iron pipe with 2 1/2" brass cap, stamped as shown above, 1.3' below the surface. The corner location was reestablished by single proportionate method on the line held between BLM caps on the North line of T2N.

**References Set:**

"Deep One" magnets by Berntsen.  
An orange magnet lies N 45° W, 31.91', 1.6' deep.  
A silver magnet lies N 31° E, 33.13', 1.6' deep.  
A pink magnet lies S 46° E, 26.97', 1.6' deep.  
A blue magnet lies S 46° W, 30.11', 1.6' deep.

**Location and Comments:**

The corner is located 1 mile South and 1/2 mile West of the intersection of Hwy. 11 and South Market Rd., at the intersection of field lines to the North, East, and West.

**Compass Declination**

17° E

**Surveyors Seal**

REGISTERED  
PROFESSIONAL  
LAND SURVEYOR

*Robert D. English*  
OREGON  
JANUARY II, 2005  
ROBERT DOUGLAS ENGLISH  
43406LS

RENEWAL DATE: 12/31/13

**RECEIVED BY:**

Date: 7/10/2012  
Rec'd By: S. Pres  
No. 12-094-C

**Firm / Agency**

Survey One, LLC.  
P.O. Box 382  
Pendleton, OR 97801  
(541) 276-2055