

**OREGON CORNER RESTORATION FORM**

Section: 34, 35 Township: 3N Range: 33E  
 County: Umatilla Date: 12/15/2011

Corner Designation: 3N33Z17

Section corner common to Sections 34, 35, T3NR33E.

	Condition Report Only
X	Not Found
X	Remonumented
	Unrecorded
X	Surveyed In
X	Referenced Out


**Previous Renewals / Surveys, etc.**

Originally surveyed by Thompson in 1864. He set a post in a mound of earth with charred stake, pits, and a trench.  
 In 1871 Moody set a post in a mound of earth.  
 In 1887 Currin and Noland set a post in a mound of earth and dug pits.  
 In 1887 Currin and Noland raised a mound of earth over charred stake, dug pits, and placed a stake in the East pit for the closing corner.  
 In 1910 J. Kimbrell found the corner in Private Survey 322 as recorded in Book 2, pg. 179.


**Monuments and Accessories Found: (Condition and Source):**

None.

**Diagram**

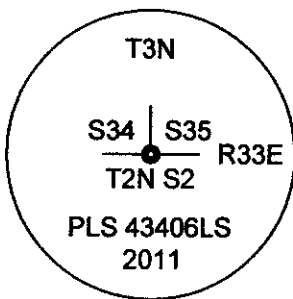

**Sketch**

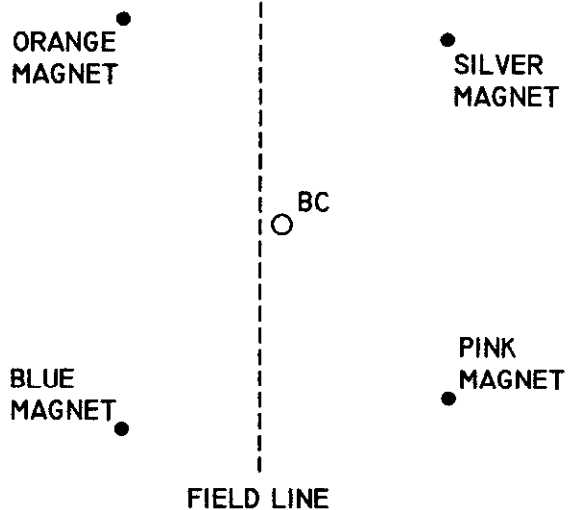

NAD 83/91  
 OREGON STATE PLANE NORTH  
 INTERNATIONAL FEET  
 N742534.84  
 E8671541.65

**Monument(s) Set (Procedures and Description):**

A 1 1/8" x 30" galvanized iron pipe with 2 1/2" brass cap, stamped as shown above, 1.5' below the surface. The corner location was reestablished by single proportionate method from found monuments East and West.

**References Set:**

"Deep One" magnets by Bermtsen.  
 An orange magnet lies N 36° 30' W, 27.04', 1.6' deep.  
 A silver magnet lies N 43° 10' E, 25.84', 1.6' deep.  
 A pink magnet lies S 43° E, 25.18', 1.7' deep.  
 A blue magnet lies S 39° 10' W, 27.12', 1.6' deep.

**Location and Comments:**

The corner is located 1 mile South and 1 mile East of the intersection of Hwy. 11 and South Market Rd.

**Compass Declination**

17° E

**Surveyors Seal**

REGISTERED  
 PROFESSIONAL  
 LAND SURVEYOR

*Robert D. English*  
 OREGON  
 JANUARY II, 2005  
 ROBERT DOUGLAS ENGLISH  
 43406LS

RENEWAL DATE: 12/31/13

**RECEIVED BY:**

Date: 7/10/2012  
 Rec'd By: S. Oles  
 No. 12-094-C

**Firm / Agency**

Survey One, LLC.  
 P.O. Box 382  
 Pendleton, OR 97801  
 (541) 276-2055