

OREGON CORNER RESTORATION FORM

Section: 36 Township: 3N Range: 33E
 County: Umatilla Date: 12/14/2011

Corner Designation: 3N33Z23

South quarter corner of Section 36 only.

	Condition Report Only
X	Not Found
X	Remonumented
	Unrecorded
X	Surveyed In
X	Referenced Out


Previous Renewals / Surveys, etc.

Originally surveyed by Thompson in 1864. He set a post in a mound of earth with charred stake, pits, and a trench.
 In 1871 Moody set a post in a mound of earth.
 In 1887 Currin and Noland set a post in a mound of earth with charred stake and pits.
 In 1887 Currin and Noland found pits and a mound.


Monuments and Accessories Found: (Condition and Source):

None.

Diagram

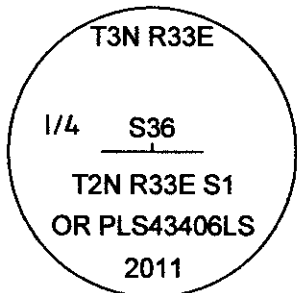

Sketch

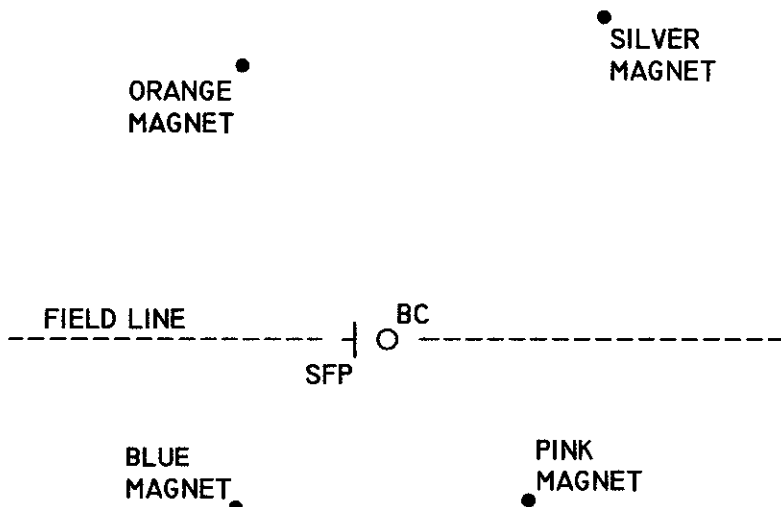

NAD 83/91
 OREGON STATE PLANE NORTH
 INTERNATIONAL FEET

N742695.37
 E8679445.51

Monument(s) Set (Procedures and Description):

A 1 1/8" x 30" galvanized iron pipe with 2 1/2" brass cap, stamped as shown above, 8" below the surface, with a steel fence post 1' to the West.
 The corner location was reestablished by single proportionate method between found monuments East and West.

References Set:

"Deep One" magnets by Bermtsen.
 An orange magnet lies N 26° 40' W, 32.17', 1.7' deep.
 A silver magnet lies N 35° 15' E, 40.31', 1.7' deep.
 A pink magnet lies S 40° 30' E, 22.51', 1.6' deep.
 A blue magnet lies S 43° 10' W, 23.68', 1.6' deep.

Location and Comments:

The corner is located 1 1/2 miles West of the intersection of North Cayuse Rd. and Rothrock Rd.

Compass Declination

17° E

Surveyors Seal

REGISTERED
 PROFESSIONAL
 LAND SURVEYOR

Robert D. English
 OREGON
 JANUARY 11, 2005
 ROBERT DOUGLAS ENGLISH
 434.06LS

RENEWAL DATE: 12/31/13

RECEIVED BY:

Date: 7/10/2012
 Rec'd By: S. Oles
 No. 12-094-C

Firm / Agency

Survey One, LLC.
 P.O. Box 382
 Pendleton, OR 97801
 (541) 276-2055