

OREGON CORNER RESTORATION FORM

Section: 32, 33 Township: 3N Range: 33E
County: Umatilla Date: 8/17/2011

Corner Designation: 3N33Z09

Section corner common to Sections 32, 33, T3NR33E.

- Condition Report Only
- Not Found
- Remonumented
- Unrecorded
- Surveyed In
- Referenced Out


Previous Renewals / Surveys, etc.

Originally surveyed by Thompson in 1864. He set a post in a mound of earth.
 In 1871 Moody set a post in a mound of earth.
 In 1887 Currin and Noland set a 10" x 8" x 7" basalt stone.
 In 1887 Currin and Noland set a post in a mound of earth at the closing corner to Sections 32, 33.
 In 1902 Macomber recovered the remains of a post and set pieces of charred stake beneath 5 small stones in a Private Survey recorded in Book No. 1, pp 458, 459.
 In 2007 W. Wells set a 1 1/4" galvanized iron pipe with a 2 3/8" brass cap, stamped as shown below, 2" above the surface.

Monuments and Accessories Found: (Condition and Source):

A 2 1/2" brass cap, stamped as shown below, 2.5' North of a railroad tie post, flush with the surface.


Diagram

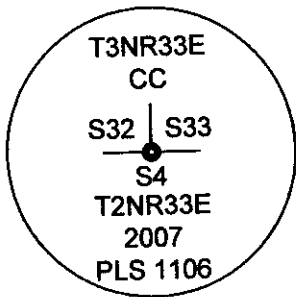

NAD 83/91
OREGON STATE PLANE NORTH
INTERNATIONAL FEET

N742332.06
E8660979.10

Sketch

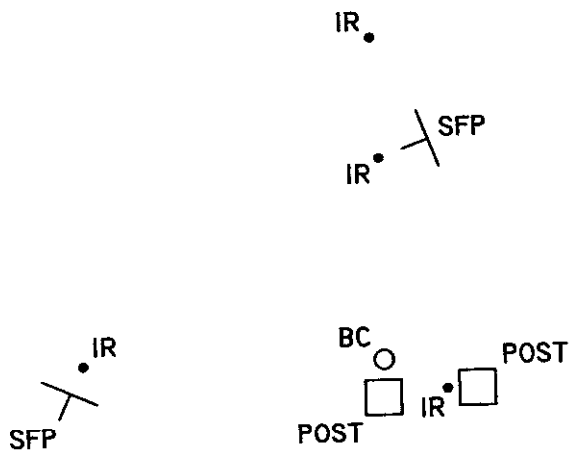

Monument(s) Set (Procedures and Description):

None.

References Set:

- A 5/8" x 30" iron rebar w/RPC #43406 lies N 0° 45' W, 79.61'.
- A 5/8" x 30" iron rebar w/RPC #43406 lies N 0° 45' W, 26.21', with a steel fence post.
- A 5/8" x 30" iron rebar w/RPC #43406 lies S 58° 10' E, 6.55', at a post.
- A 5/8" x 30" iron rebar w/RPC #43406 lies S 89° 30' W, 40.06', with a steel fence post.

Location and Comments:

The corner is located 1 mile South and 1 mile West of the intersection of Hwy. 11 and South Market Rd.

Compass Declination

17° E

Surveyors Seal

REGISTERED
PROFESSIONAL
LAND SURVEYOR

Robert D. English
 OREGON
 JANUARY 11, 2005
 ROBERT DOUGLAS ENGLISH
 43406LS

RENEWAL DATE: 12/31/13

RECEIVED BY:

Date: 7/10/2012
 Rec'd By: S. Pres
 No. 12-094-C

Firm / Agency

Survey One, LLC.
 P.O. Box 382
 Pendleton, OR 97801
 (541) 276-2055