

**OREGON CORNER RESTORATION FORM**

Section: 1, 6, 31, 36  
County: Umatilla

Township: 3N, 4N  
Date: 2/9/2011

Range: 33E, 34E

Corner Designation: 3N33A25

Township corner common to Sections 1, T3NR33E; 6, T3NR34E; 31, T4NR34E; 36, T4NR33E.

- Condition Report Only
- Not Found
- Remonumented
- Unrecorded
- Surveyed In
- Referenced Out


**Previous Renewals / Surveys, etc.**

Originally surveyed by Thompson in 1864. He set a post in a mound of earth with charred stake, pits, and trench. In 1976 Krumbein set a brass cap at the road intersection in Survey M-121-C. In 2002 Tomkins found a 2 1/2" brass capped witness corner and a pk nail at the corner location in Survey 03-25-B.


**Monuments and Accessories Found: (Condition and Source):**

- A 2 1/2" brass cap, stamped as shown below.
- A 5/8" iron rebar w/YPC LS2360 lies N 67° 13' E, 66.65'.
- A 5/8" iron rebar w/YPC LS2360 lies N 33° 11' W, 47.23'.
- A 5/8" iron rebar w/YPC LS2360 lies S 1° 43' W, 18.94'.
- A 2 1/2" brass capped witness corner lies S 78° 15' E, 56.93'.

Diagram

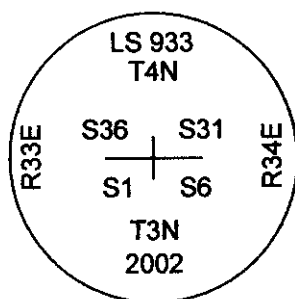

Sketch

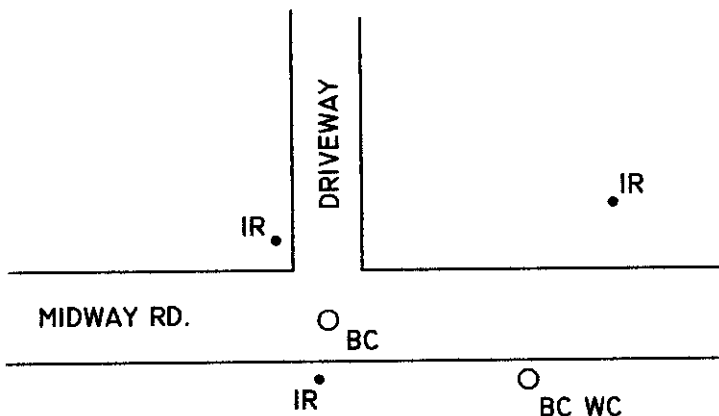

NAD 83/91  
OREGON STATE PLANE NORTH  
INTERNATIONAL FEET  
N774553.63  
E8681225.39

**Monument(s) Set (Procedures and Description):**

None.

**References Set:**

None.

**Location and Comments:**

The corner is located at the intersection of Midway Rd. and Hales Rd.

**Compass Declination**

17° E

**Surveyors Seal**

REGISTERED  
PROFESSIONAL  
LAND SURVEYOR

*Robert D. English*

OREGON  
JANUARY 11, 2005  
ROBERT DOUGLAS ENGLISH  
43406LS

RENEWAL DATE: 12/31/13

**RECEIVED BY:**

Date: 7/10/2012  
Rec'd By: *[Signature]*  
No. 12-094-C

**Firm / Agency**

Survey One, LLC.  
P.O. Box 382  
Pendleton, OR 97801  
(541) 276-2055