

OREGON CORNER RESTORATION FORM

Section: 1, 6

Township: 3N

Range: 33E, 34E

County: Umatilla

Date: 10/4/2011

Corner Designation: 3N33C25

Quarter corner common to Sections 1, T3NR33E; 6, T3NR34E.

_____	Condition Report Only
X	Not Found
X	Remonumented
_____	Unrecorded
X	Surveyed In
X	Referenced Out


Previous Renewals / Surveys, etc.

Originally surveyed by Thompson in 1864. He set a post in a mound of earth with charred stake, pits, and trench.


Monuments and Accessories Found: (Condition and Source):

None.

Diagram

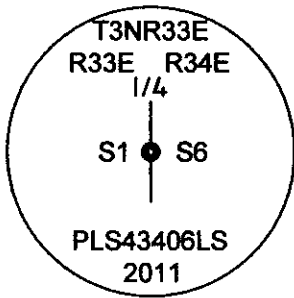

Sketch

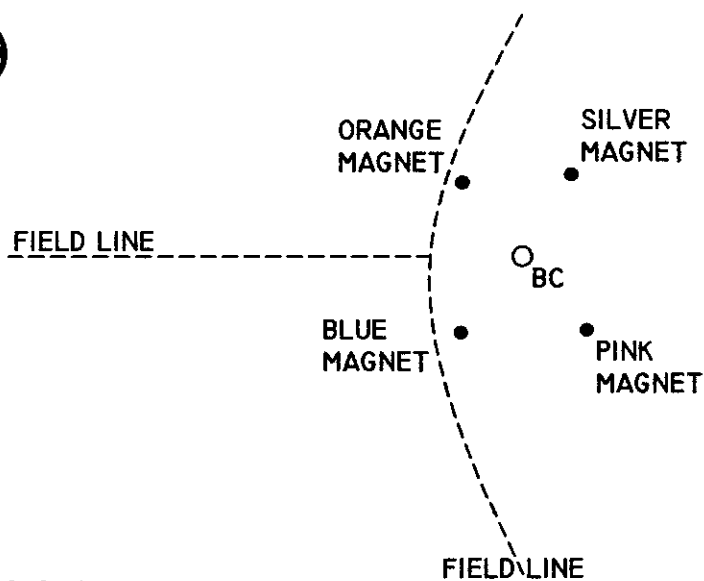

NAD 83/91
OREGON STATE PLANE NORTH
INTERNATIONAL FEET

N771907.45
E8681335.64

Monument(s) Set (Procedures and Description):

A 1 1/8" x 30" galvanized iron pipe with a 2 1/2" brass cap, stamped as shown above, 1.8' below the surface. The corner location was reestablished by holding the North-South line between existing monuments and using single proportionate method for Northing. This fits well with an East-West fence to the West of the corner and to an old plow line East of the corner.

References Set:

- "Deep One" magnets by Berntsen.
- An orange magnet lies N 37° 50' W, 25.91', 1.8' deep.
- A silver magnet lies N 32° E, 27.67', 1.7' deep.
- A pink magnet lies S 40° 10' E, 24.99', 1.7' deep.
- A blue magnet lies S 40° 10' W, 25.11', 1.7' deep.

Location and Comments:

The corner is located 1/2 mile South and 1 mile West of the intersection of Midway Rd. and Rothrock Rd.

Compass Declination

17° E

Surveyors Seal

REGISTERED
PROFESSIONAL
LAND SURVEYOR

Robert D. English

OREGON
JANUARY II, 2005
ROBERT DOUGLAS ENGLISH
43406LS

RECEIVED BY:

Firm / Agency

Date: 7/10/2012
Rec'd By: S. Oles
No. 12-094-C

Survey One, LLC.
P.O. Box 382
Pendleton, OR 97801
(541) 276-2055

RENEWAL DATE: 12/31/13