

OREGON CORNER RESTORATION FORM

COUNTY: Umatilla DATE: 9/04/15

CORNER DESIGNATION: G-9, The East Quarter Corner of Section 8, Township 3 North, Range 34 East, W.M.

PREVIOUS RENEWALS/SURVEYS ETC.: Corner originally established by Wm. Odell, under Contract No. 114, dated July 2, 1866, states "set post corner for 1/4 section corner, drove a charred stake, dug pits and raised mound as per instructions. Currin and Noland under contract dated May 4th, 1887, found this corner stating "Commencing at the 1/4 sec. corner between secs. 8 & 9, which is a post 3 ft. long, 3" square, 24" in the ground, fairly preserved in old mound with 2 pits.

MONUMENT AND ACCESSORIES FOUND: None. Held the projection of field berms North and East (field corner is rounded) as the best remaining evidence of the original corner.

MONUMENT MARKING DETAIL:

T3N R34E
 1
 4
S8|S9
2015
PLS 54657

MONUMENT SET: Set a 2 3/8" brass cap on 1 1/4"x30" galvanized iron pipe with the top of the monument set 22" below ground level in farmed field. Monument marked as shown in "Monument Marking Detail".

From which:

A silver Deep-1 magnet buried 20" in the ground bears North 40° East, 24.0 feet.

A pink Deep-1 magnet buried 20" in the ground bears South 28° East, 27.7 feet.

A blue Deep-1 magnet buried 20" in the ground bears South 70° West, 34.9 feet.

A orange Deep-1 magnet buried 20" in the ground bears North 33° West, 32.4 feet.

Buried bearing object signs with magnets.

LOCATION AND COMMENTS: Corner is located in a farmed field at the projection of field berms North and East.

APPROXIMATE OREGON NORTH ZONE (NAD83/91) STATE PLANE COORDINATES:

NORTH = 766806


EAST = 8691845

FIRM: Wells Surveying
P.O. Box 1696
Pendleton, OR 97801

COMPASS DECLINATION: 18° East

Surveyor's Seal

/3N34G9

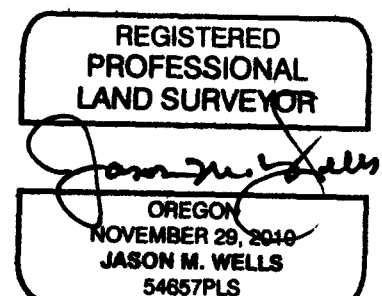

RENEWS: 6:30!16

15-088-B